


WALWORTH COUNTY
SURVEYING & MAPPING
LAKE GENEVA, WISCONSIN

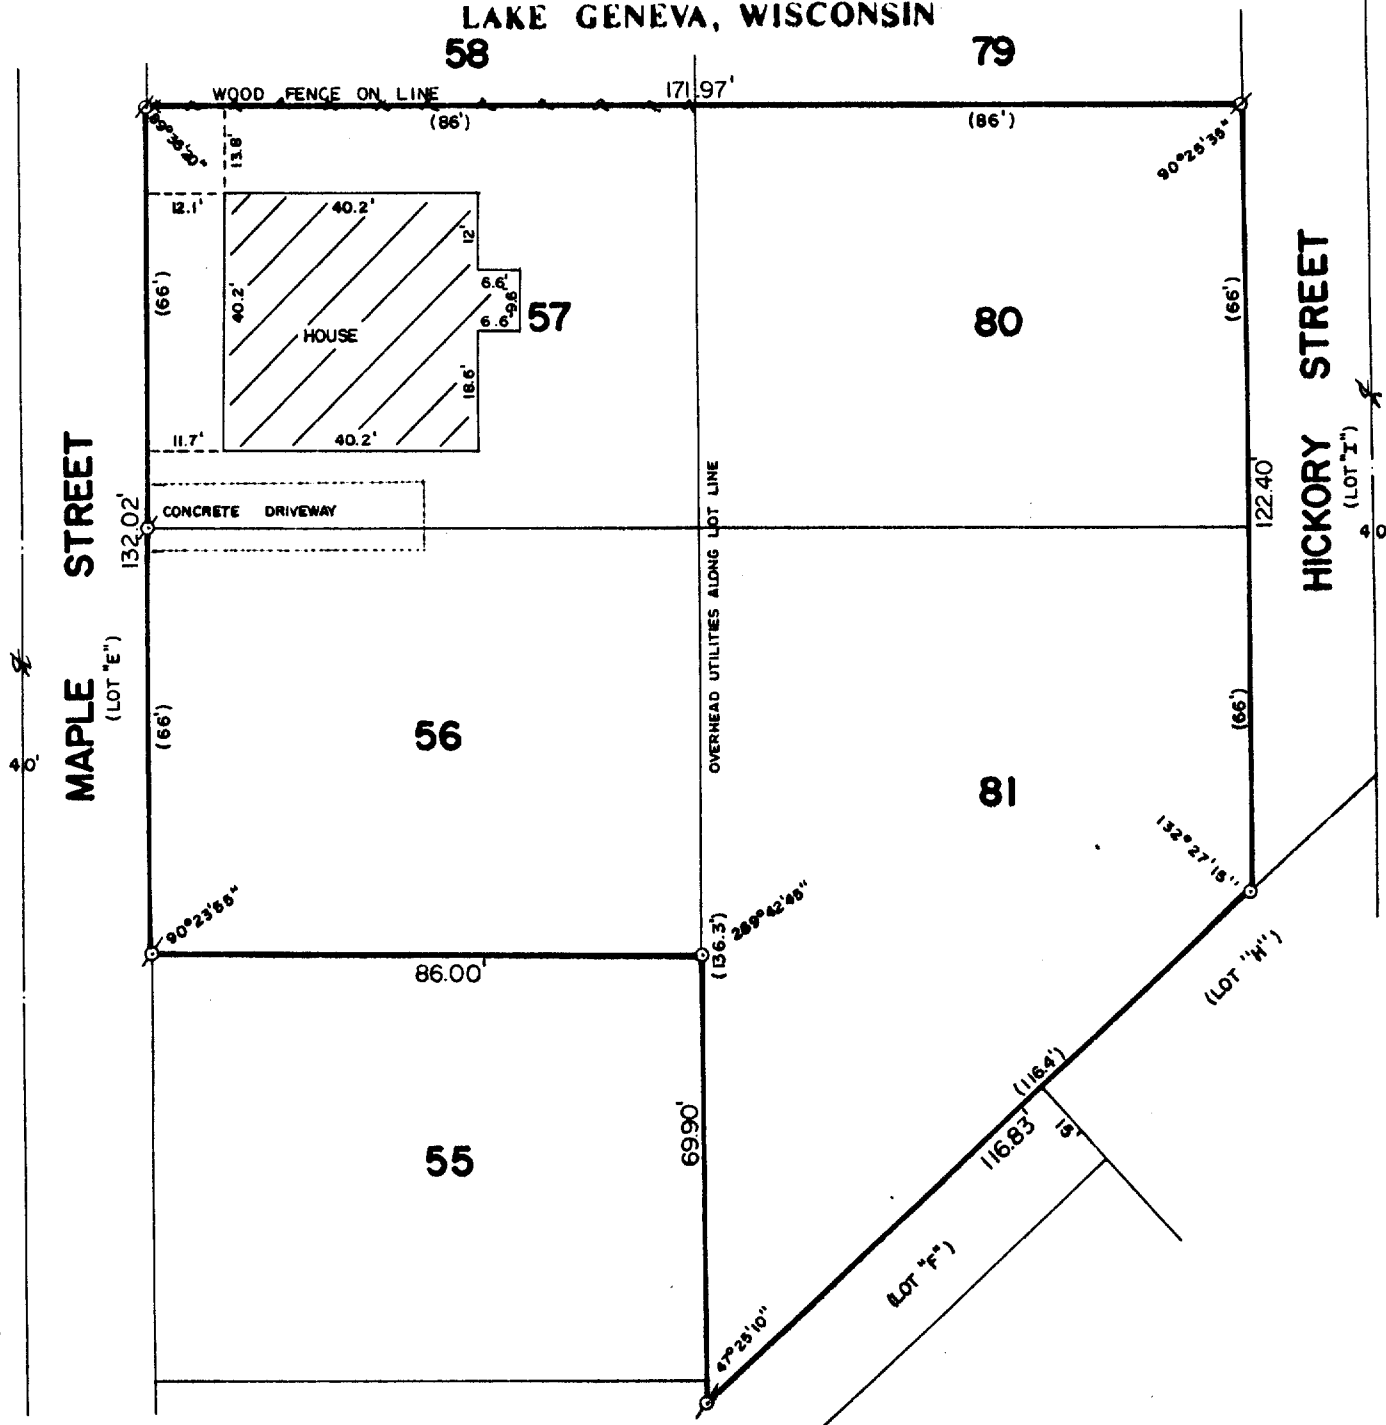

RECEIVED
JUL 19 1989
[Signature]

PLAT OF SURVEY OF

LOTS 56, 57, 80 AND 81 OF ROBINSON'S
SECOND SUBDIVISION, LOCATED IN SECTIONS
11 AND 14, T 1 N, R 17 E, WALWORTH COUNTY,
WISCONSIN.

ORDERED BY: RIEMER LAW OFFICE
601 E. WALWORTH
DELAVER, WISCONSIN
53115



SCALE: 1"=30'

- Ø - IRON PIPE FOUND
- ⊘ - IRON ROD FOUND
- - IRON ROD PLACED
- () - RECORDED AS

I HEREBY CERTIFY THAT I HAVE SURVEYED THE ABOVE DESCRIBED PROPERTY AND THAT THE ABOVE
MAP IS A TRUE REPRESENTATION THEREOF AND SHOWS THE SIZE AND LOCATION OF THE PROPERTY,
ITS EXTERIOR BOUNDARIES, THE LOCATION OF ALL VISIBLE STRUCTURES AND DIMENSIONS OF ALL
PRINCIPAL BUILDINGS THEREON, BOUNDARY FENCES, APPARENT EASEMENTS AND ROADWAYS AND
VISIBLE ENCROACHMENTS, IF ANY.

THIS SURVEY IS MADE FOR THE EXCLUSIVE USE OF THE PRESENT OWNERS OF THE PROPERTY, AND
ALSO THOSE WHO PURCHASE, MORTGAGE, OR GUARANTEE THE TITLE THERETO WITHIN ONE (1) YEAR
FROM DATE HEREOF.

Robert M. Baerenwald
ROBERT M. BAERENWALD
WISCONSIN REGISTERED LAND SURVEYOR, S-1508

March 1, 1989
DATE JOB NO. 1863

NOTE: THIS IS NOT A CERTIFIED COPY UNLESS SEALED.

IRB2-42,42A,63

117-979