



**SCALE** 1"=40' I HEREBY CERTIFY THAT I HAVE SURVEYED THE ABOVE DESCRIBED PROPERTY AND THAT THE ABOVE MAP IS A TRUE REPRESENTATION THEREOF AND SHOWS THE SIZE AND LOCATION OF THE PROPERTY, ITS EXTERIOR BOUNDARIES, THE LOCATION OF ALL VISIBLE STRUCTURES AND DIMENSIONS OF ALL PRINCIPAL BUILDINGS THEREON, BOUNDARY FENCES, APPARENT EASEMENTS, ROADWAYS AND VISIBLE ENCROACHMENTS, IF ANY, TO THE BEST OF MY KNOWLEDGE AND BELIEF.

THIS SURVEY IS MADE FOR THE USE OF THE PRESENT OWNERS OF THE PROPERTY, AND ALSO THOSE WHO FURCHASE, MORICAGE, OR GUARANTEE THE TITLE THERETO WITHIN ONE (1) YEAR FROM DATE HEREOF.

- IRON ROD SET 12-10-90
- WALWORTH COUNTY
SECTION COT LEGEND

SECTION CORNER MONUMENT FOUND

( )- RECORDED AS

DAVID F. ABELL WISCONSIN REGISTERED LAND SURVEYOR, S-1596


anuary 10, 1990

THIS IS NOT A CERTIFIED COPY UNLESS SEALED.

ILGT-BIB

117 - 998

ILGT - 20C

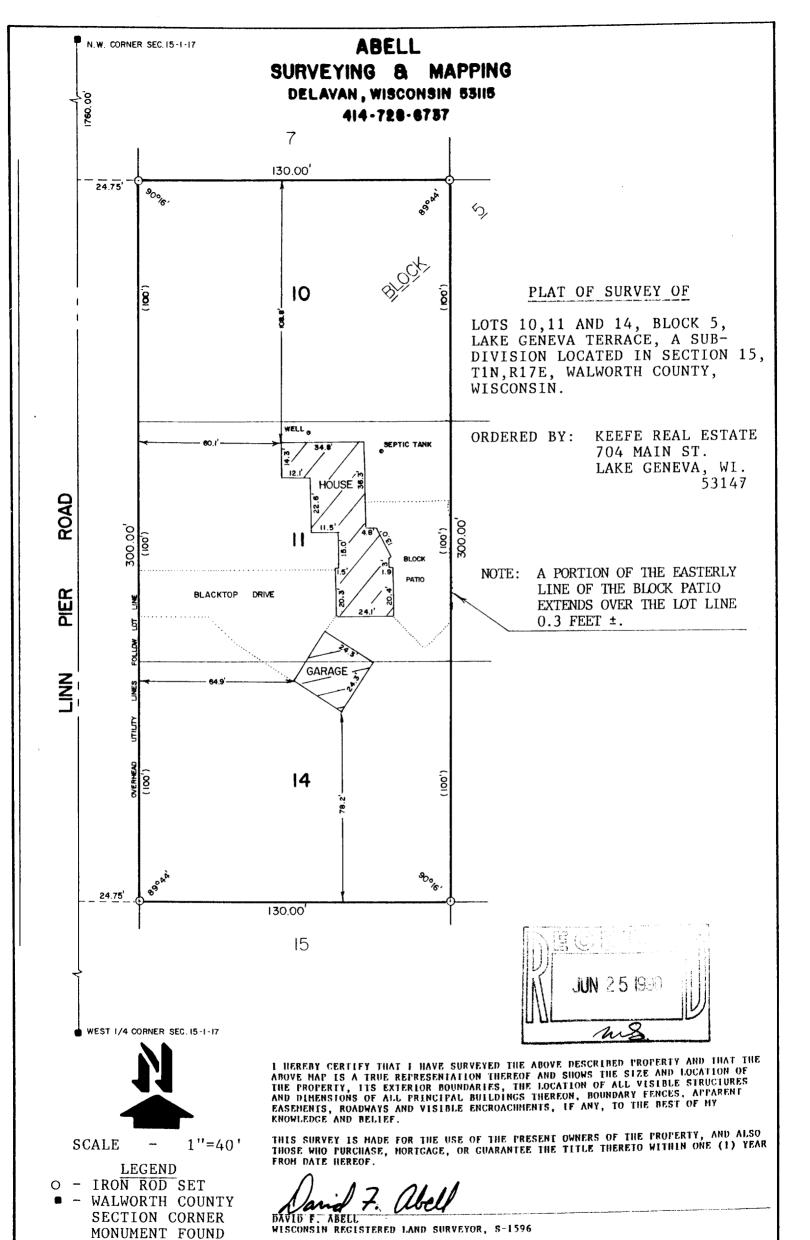

DATE THIS IS NOT A CERTIFIED COPY UNLESS SEALED.

( )- RECORDED AS

ILGT-21A

TAX # SILGT - 200

117-998