

FARRIS, HANSEN & ASSOCIATES, INC.

7 RIDGEWAY COURT, P.O. BOX 437
ELKHORN, WISCONSIN 53121


PHONE: (414) 723-2098
FAX: (414) 723-5886

PARCEL 8 WILDERLAND (AN UNRECORDED SUBDIVISION)
LOCATION: SE 1/4 OF SEC. 5, T. 1 N., R. 18 E
WALWORTH COUNTY, WISCONSIN

MAP LEGEND

- = IRON PIPE STAKE FOUND
- = IRON PIPE STAKE SET
- = IRON ROD STAKE FOUND
- = IRON ROD STAKE SET
- = CONCRETE MONUMENT FOUND
- = RECORD DIMENSION

WORK ORDERED BY: THELEN TOTAL CONSTRUCTION

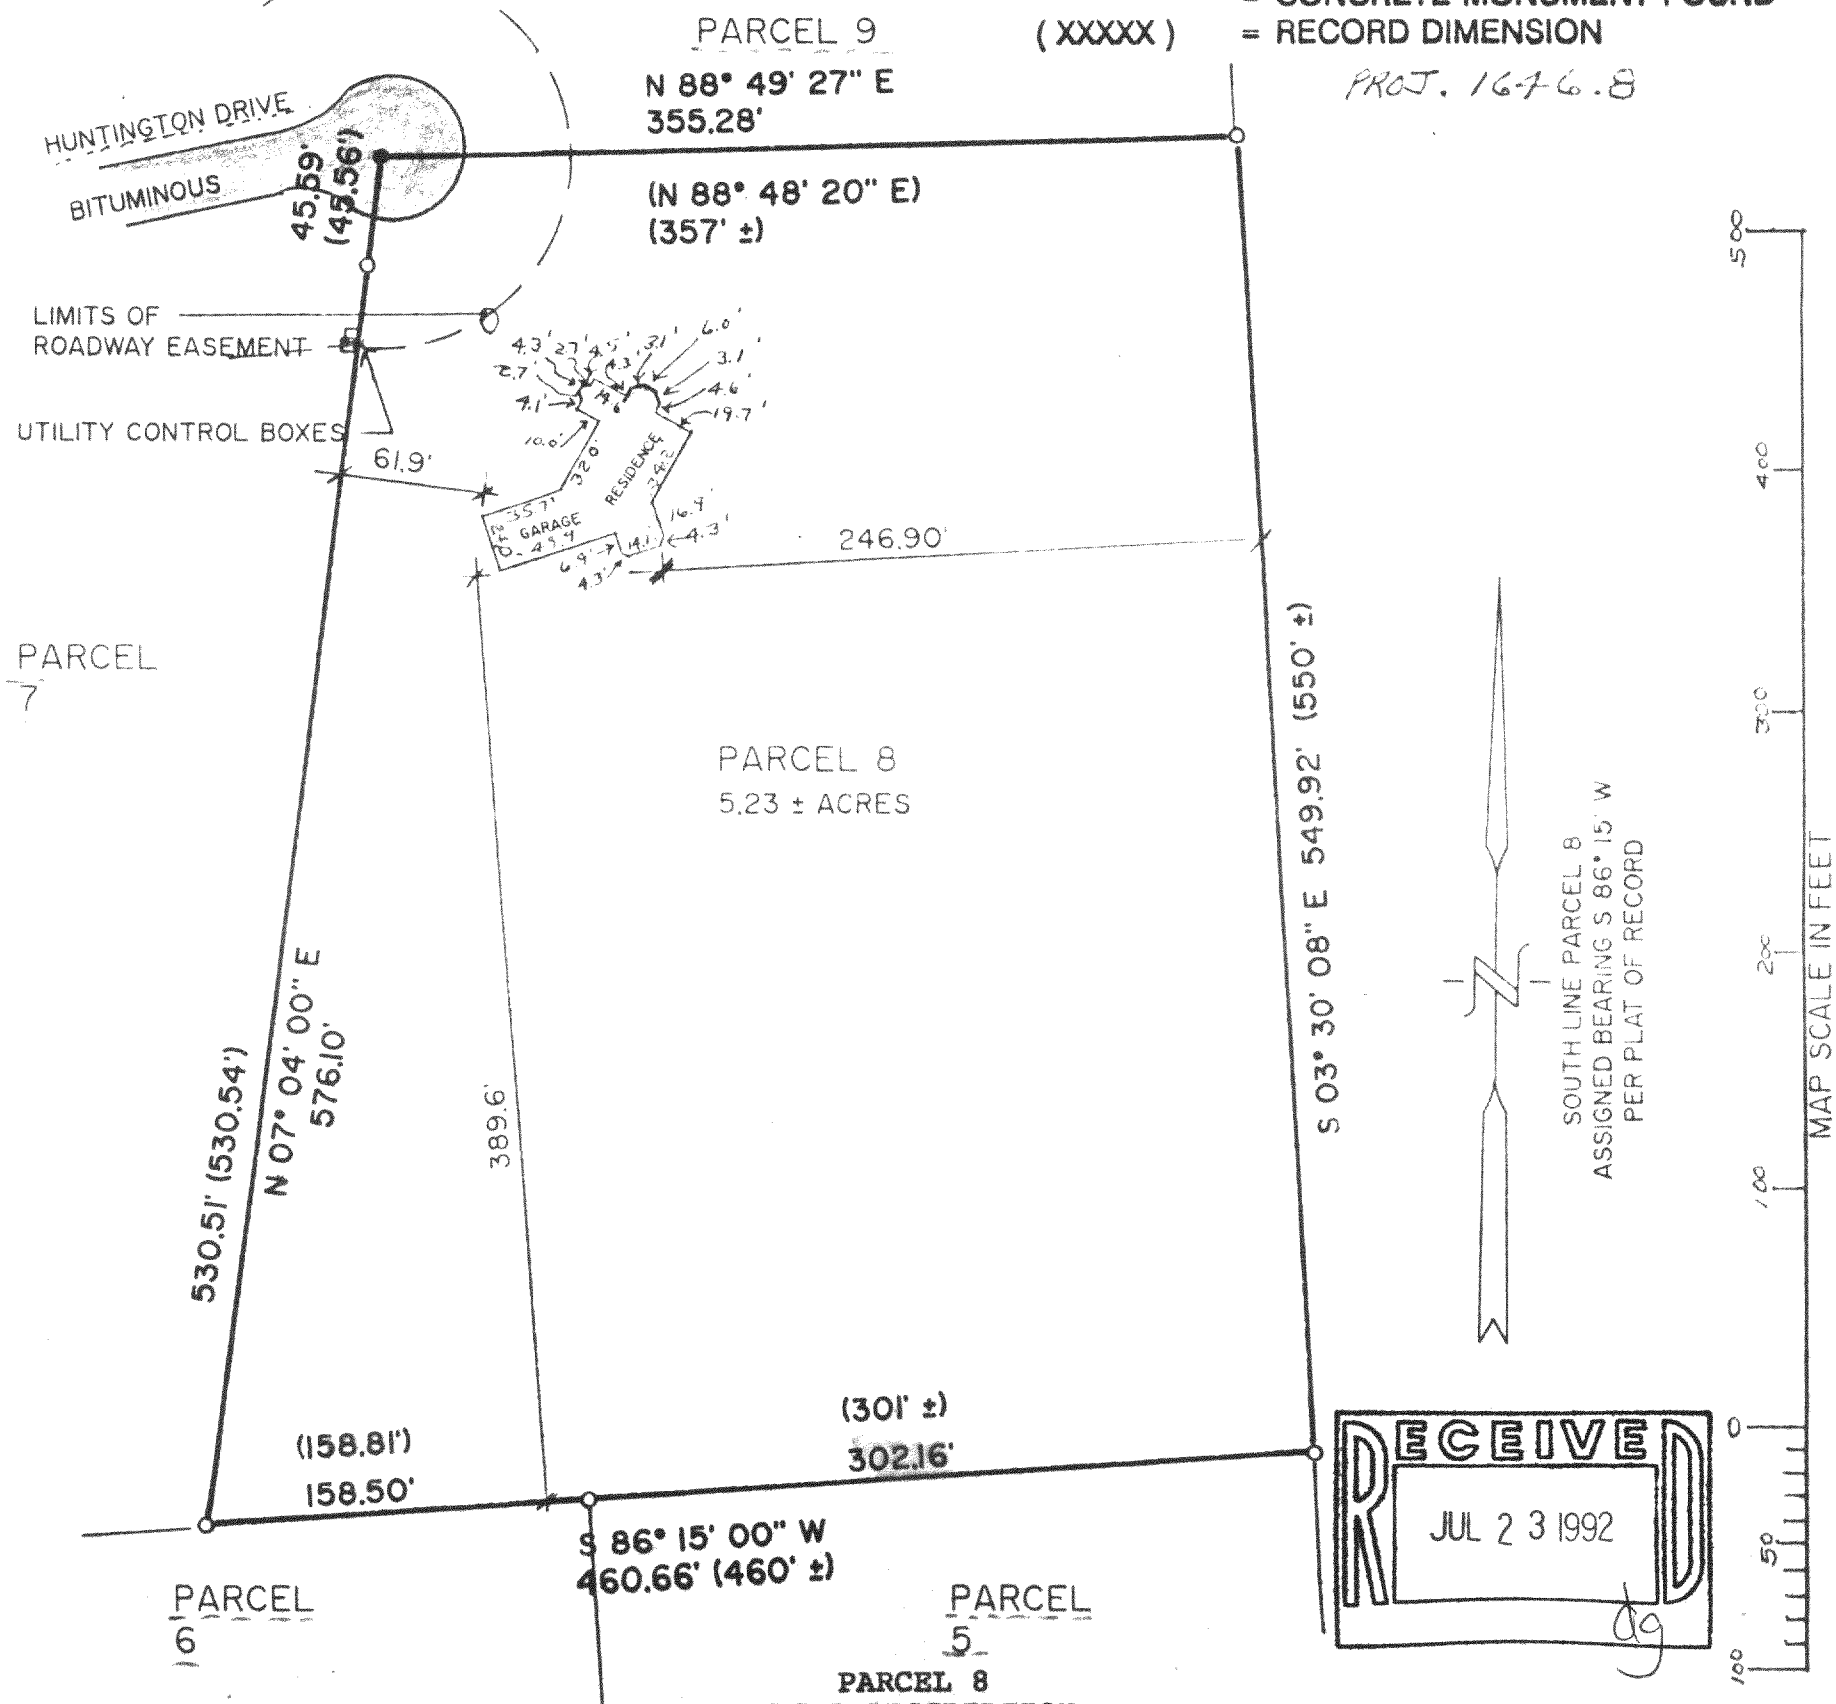

LEGAL DESCRIPTION

PART OF THE NORTHWEST 1/4 OF THE SOUTHEAST 1/4 AND PART OF THE SOUTHWEST 1/4 OF THE SOUTHEAST OF SECTION 5, TOWN 1 NORTH, RANGE 18 EAST, WALWORTH COUNTY, WISCONSIN, BEING MORE PARTICULARLY DESCRIBED AS FOLLOWS; COMMENCING AT THE SOUTHWEST CORNER OF LOT 1 OF CERTIFIED SURVEY MAP NO. 976 AS RECORDED IN VOL. 4, PG. 239 OF CERTIFIED SURVEY MAPS, WALWORTH COUNTY; THENCE S 10DEG 48MIN E, 172.00 FEET; THENCE S 03DEG 54MIN 30SEC E, 452.85 FEET TO THE POINT OF BEGINNING; THENCE S 07DEG 04MIN W, 576.10 FEET; THENCE N 86DEG 15MIN E, 460 FEET, MORE OR LESS, TO THE EAST LINE OF THE WEST 1/2 OF THE SOUTHEAST 1/4 OF SAID SECTION 5; THENCE NORTHERLY 550.00 FEET ALONG SAID EAST LINE; THENCE S 88DEG 48MIN 20SEC W, 357 FEET, MORE OR LESS, TO THE POINT OF BEGINNING. CONTAINING 5.23 ACRES OF LAND MORE OR LESS.

NOTE: COPIES OF THIS MAP TO WHICH THE FOLLOWING CERTIFICATE WILL APPLY ARE BLUE LINE PRINTS SHOWING SURVEYOR'S ORIGINAL SEAL AND SIGNATURE IN BLACK INK. COPIES BY ANY OTHER MEANS MAY HAVE ALTERATIONS WHICH DO NOT REPRESENT THE SURVEYOR'S WORK PRODUCT.

I HEREBY CERTIFY THAT THIS PLAT OF SURVEY IS A TRUE AND ACCURATE REPRESENTATION OF THE BOUNDARY LINES OF THE SUBJECT PARCEL AND SHOWS THE SIZE AND LOCATION OF ALL BUILDINGS ON THE PARCEL SHOWN HEREON, TO THE BEST OF MY PROFESSIONAL KNOWLEDGE AND BELIEF. THIS SURVEY IS MADE FOR THE USE OF THE PRESENT OWNERS OF THE PROPERTY, AND ALSO THOSE WHO PURCHASE, MORTGAGE, OR GUARANTEE THE TITLE THERETO WITHIN ONE YEAR FROM THE DATE HEREOF.

DATED: JULY 17, 1992

PETER S. GORDON RLS 2101

