


HAROLD H. KOLB

REGISTERED PROFESSIONAL LAND SURVEYOR
LAKE GENEVA, WISCONSIN

NOTE: ALL PROPERTY CORNERS FOUND
AS SHOWN ON PLAT, AND LOCATED
BUILDINGS. 6-11-19
FENCE ALONG ALL PROPERTY LINE
± 1 FOOT.

SURVEY NOT VALID
UNLESS SURVEYOR'S
SIGNATURE IS IN RED.

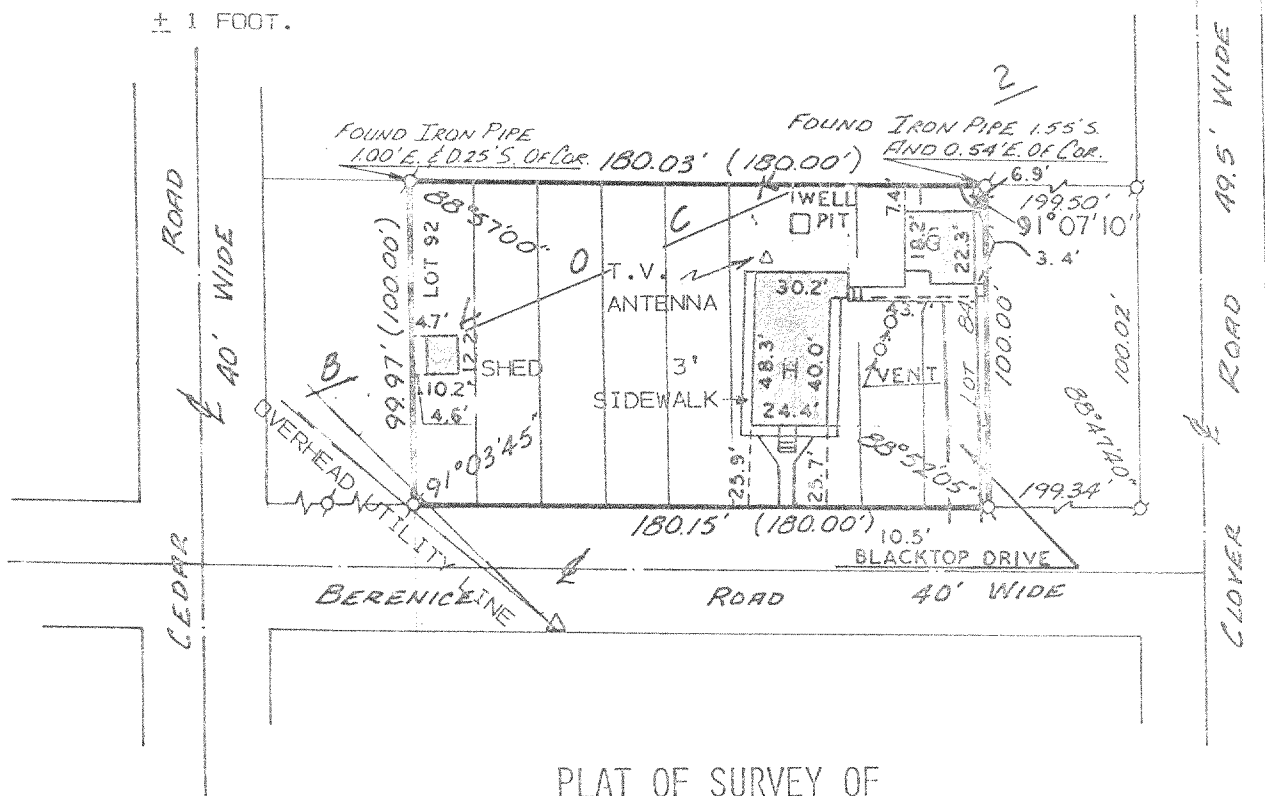

PLAT OF SURVEY OF

LOTS 84-92, BLOCK 2, PELL LAKE
HIGHLANDS, T1N, R18E, WALWORTH
COUNTY, WISCONSIN.



OWNER: IWAN ODARCZENKO

6-11-91:

ORDERED BY: PAULETTE QUAID
P.O. BOX 307
PELL LAKE, WI. 53157

ACCURACY: DISTANCES ± 0.01'
ANGLES ± 05''

ERROR OF CLOSURE--LESS THAN
ONE PART IN 3000

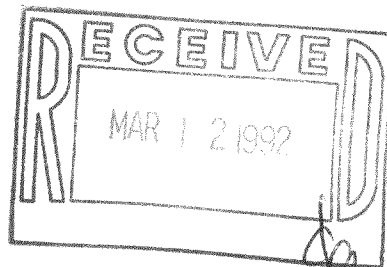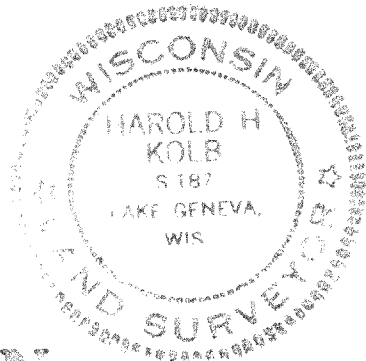

I, HAROLD H. KOLB, DO HEREBY CERTIFY THAT I HAVE
SURVEYED THE PROPERTY HEREON DESCRIBED ACCORDING
TO THE OFFICIAL RECORDS AND THAT THE PLAT HEREON
IS A CORRECT REPRESENTATION OF THE LOT LINES

Harold H. Kolb
HAROLD H. KOLB
WISCONSIN REGISTERED LAND SURVEYOR, S-187
DATE March 29, 1977
REVISED JUNE 11, 1991

LEGEND

- UTILITY POLE
- G - GARAGE
- H - HOUSE
- O - IRON PIPE PLACED.
- - CONCRETE MONUMENT
- ⊙ - IRON PIPE FOUND

SCALE: 1"=60'