


WALWORTH COUNTY
SURVEYING & MAPPING
727 HENRY STREET
LAKE GENEVA, WISCONSIN
414-248-0505



WASHINGTON AVENUE

RECEIVED
DEC 16 1992
dg

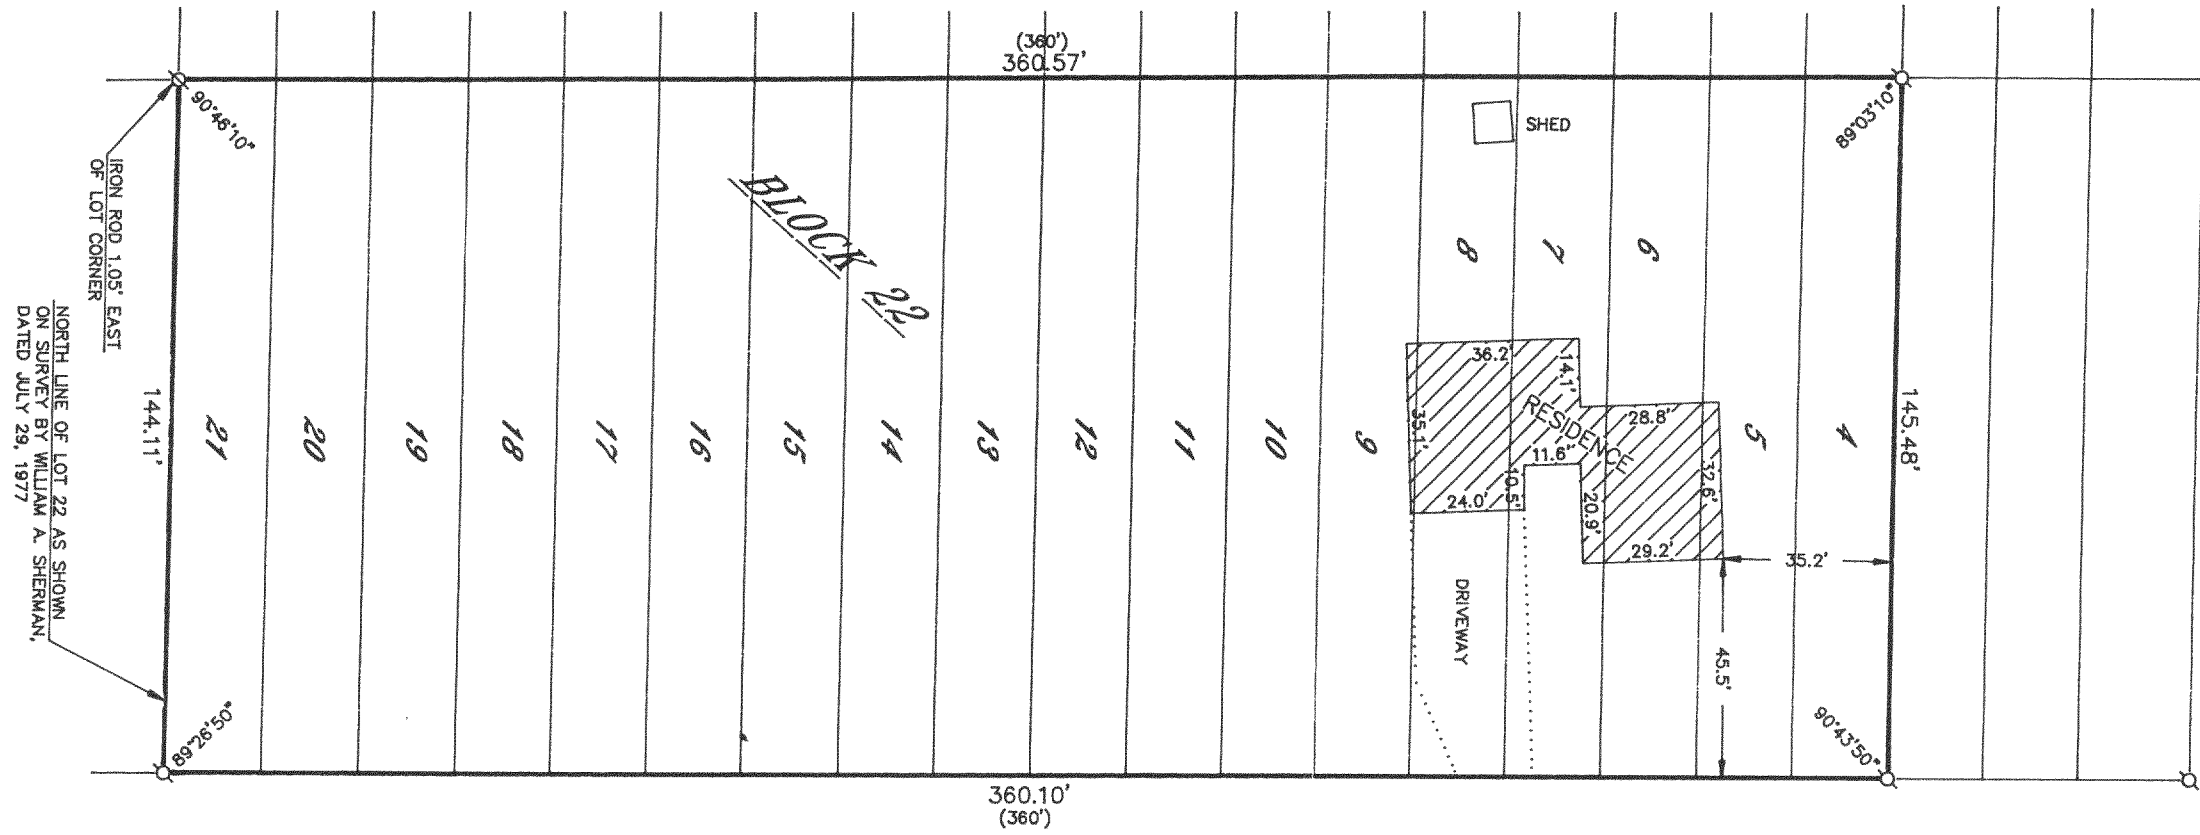

GRAPHIC SCALE



(IN FEET)
1 inch = 40 ft.

- IRON PIPE FOUND
- ⊘—IRON ROD FOUND
- CONCRETE MONUMENT FOUND
- IRON PIPE PLACED
- ()—RECORDED AS

MARIONDALE ROAD

PLAT OF SURVEY OF
LOTS 4-21, BLOCK 22 OF LAKE IVANHOE RESORT,
LOCATED IN T 1 N, R 18 E, WALWORTH COUNTY,
WISCONSIN.

ORDERED BY: IDA THOMPSON
P. O. BOX 962
LAKE GENEVA, WISCONSIN
53147

I HEREBY CERTIFY THAT I HAVE SURVEYED THE ABOVE DESCRIBED
PROPERTY AND THAT THE ABOVE MAP IS A TRUE REPRESENTATION
THEREOF AND SHOWS THE SIZE AND LOCATION OF THE PROPERTY,
ITS EXTERIOR BOUNDARIES, THE LOCATION OF ALL VISIBLE STRUCTURES
AND DIMENSIONS OF ALL PRINCIPAL BUILDINGS THEREON, BOUNDARY
FENCES, APPARENT EASEMENTS, ROADWAYS AND VISIBLE ENCROACH-
MENTS, IF ANY, TO THE BEST OF MY KNOWLEDGE AND BELIEF.

THIS SURVEY IS MADE FOR THE USE OF THE PRESENT OWNERS OF
THE PROPERTY AND ALSO THOSE WHO PURCHASE, MORTGAGE OR
QUARANTEE THE TITLE THERETO WITHIN ONE (1) YEAR FROM DATE
HEREOF.

Robert M. Baerenwald
ROBERT M. BAERENWALD
WISCONSIN REGISTERED LAND SURVEYOR, S-1508

May 31, 1992
DATE JOB NO. 1949

NOTE: THIS IS NOT A CERTIFIED COPY UNLESS SEALED.

118-1132

MIR-384
MIR-385
MIR-386