


N



SCALE ~ 1" = 20'
O = IRON PIPE

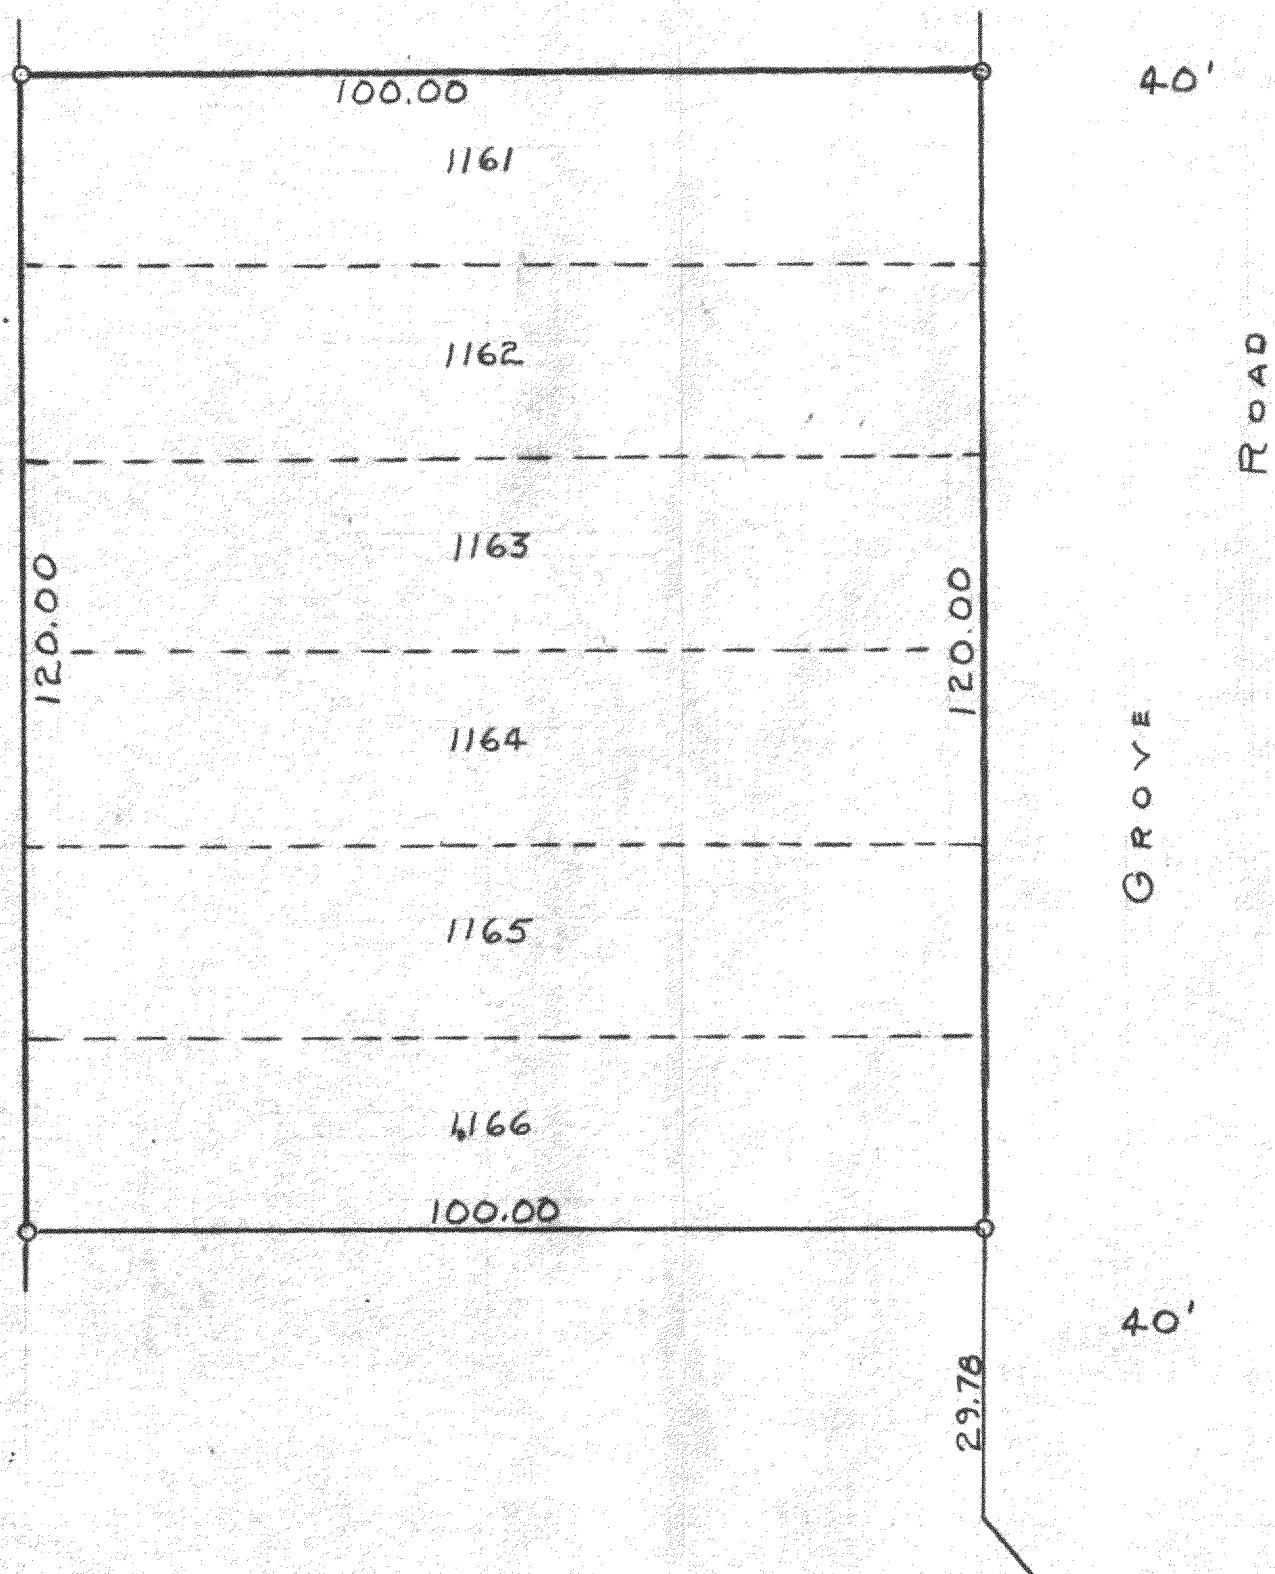

PLAT OF SURVEY OF LOTS 1161-1166 INCLUSIVE OF SECTION 1, PELL LAKE
SUBDIVISION LOCATED IN SECTION 21, T1N R1E OF WALWORTH COUNTY,
WISCONSIN
APRIL 21, 1955

MDL-256

118-12

George T. Dunham
GEORGE T. DUNHAM, SURVEYOR
DELAVER, WISCONSIN