


HAROLD H. KELB
REGISTERED PROFESSIONAL LAND SURVEYOR
LAKE GENEVA, WISCONSIN

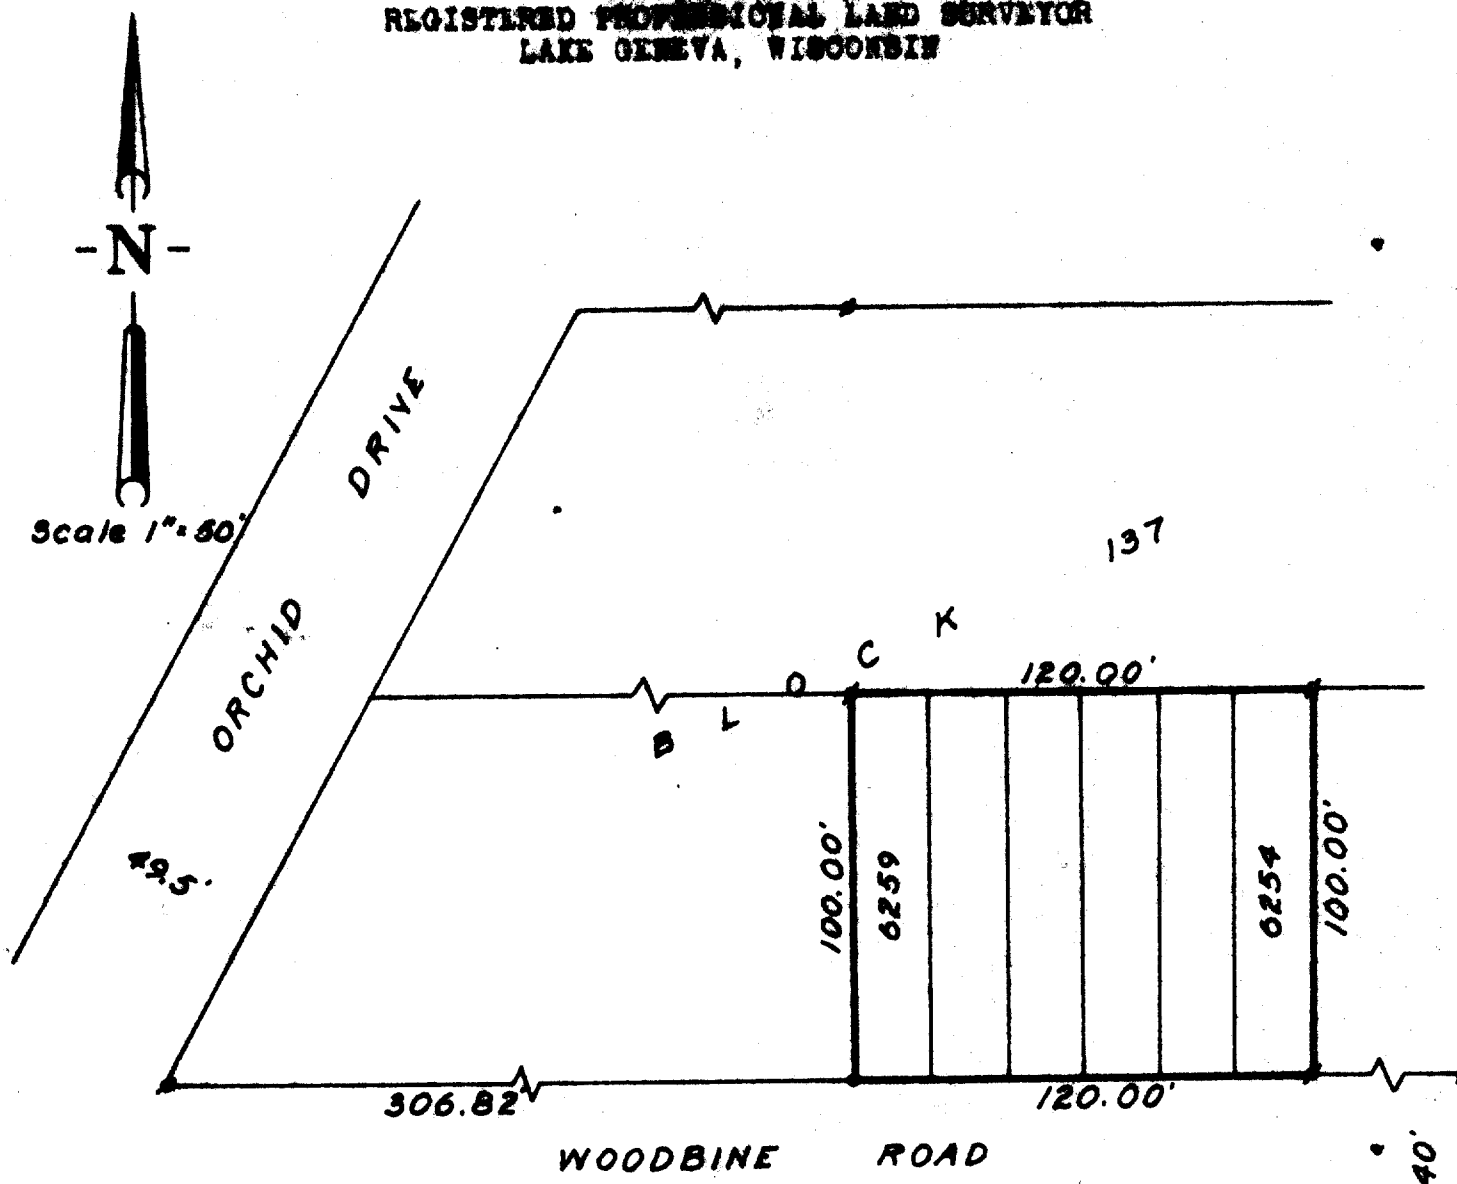

PLAT OF SURVEY OF

Lots 6254-6259, Block 137, Section 4, Pell Lake Subdivision,
Walworth County, Wisconsin.

Date July 7, 1963.

Harold H. Kelb
Harold H. Kelb, Wisconsin Surveyor, S-187

s - Iron Pipe Found
o - Iron Pipe Placed

118-124

1-18-60