
## KOLB LAND CONSULTING, INC.

LAND SURVEYING . SUBDIVIDING . LAND PLANNING

929 WILLIAMS STREET

LAKE GENEVA, WISCONSIN 53147

414-248-3697

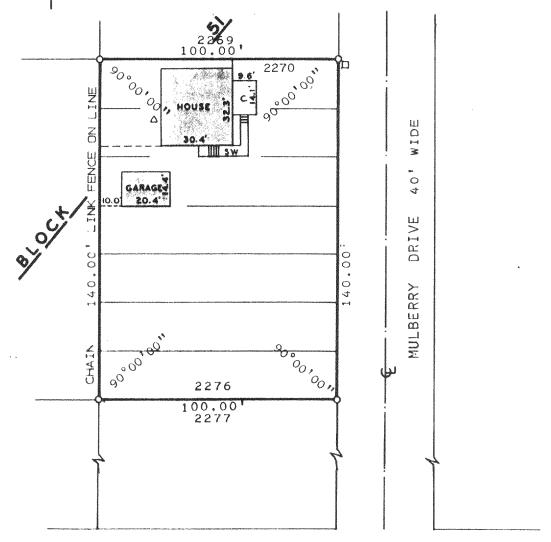

EVERGREEN ROAD 40' WIDE

ORDERED BY: LOUANNE ERICSON
P.O. BOX 83
PELL LAKE, WI. 53157

PLAT OF SURVEY OF

LOTS 2270-2276, BLOCK 51 OF PELL LAKE SUBDIVISION LOCATED IN T1N, R18E, TOWN OF BLOOMFIELD, WALWORTH COUNTY, WISCONSIN.



SCALE: 1" = 40'
LEGEND

\$ - IRON PIPE FOUND


O - IRON PIPE SET

 $\Delta$  - T.V. ANTENNA

O - UTILITY PEDISTAL

SW - SIDEWALK

C. - CONCRETE

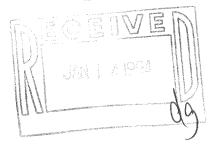

I, HAROLD H. KOLB, CERTIFY THAT I HAVE SURVEYED THE ABOVE DESCRIBED PROPERTY AND THAT THE ABOVE PLAT IS A TRUE REPRESENTATION THEREOF AND SHOWS THE SIZE AND LOCATION OF THE PROPERTY, IT'S EXTERIOR BOUNDARIES, THE LOCATION OF ALL VISIBLE STRUCTURES AND DIMENSIONS OF ALL PRINCIPAL BUILDINS THEREON, BOUNDARY FENCES, APPARENT EASEMENTS, ROADWAYS AND VISIBLE ENCROACHMENTS, IF ANY TO THE BEST OF MY KNOWLEDGE AND BELIEF.

THIS SURVEY IS MADE FOR THE USE OF THE PRESENT OWNERS OF THE PROPERTY, AND ALSO THOSE WHO PURCHASE, MORTGAGE,

OR GUARANTEE TITLE THERETO WITHIN ONE (1) YEAR FROM THE DATE HEREOF.

NOTE: THIS SURVEY IS NOT VALID UNLESSSURVEYOR'S SIGNATURE IS IN RED.

HAROLD H. KOLB

WISCONSIN REGISTERED LAND SURVEYOR, S- 187

DATE\_

REVISED\_\_

REVISED\_

1-18-434

118-1282