


WALWORTH COUNTY
SURVEYING & MAPPING
727 HENRY STREET
LAKE GENEVA, WISCONSIN
414-248-0505

PLAT OF SURVEY OF

LOT 24 OF THE FIRST ADDITION TO LAKE GENEVA AIRE ESTATES, A SUBDIVISION LOCATED IN THE SE 1/4 OF SECTION 4, AND THE NW 1/4 OF THE SW 1/4 OF SECTION 3, T 1 N, R 18 E, WALWORTH COUNTY, WISCONSIN.

EXCEPTING THEREFROM LOT 1 OF CERTIFIED SURVEY MAP NO. 894, AS FILED JANUARY 23, 1979 IN VOLUME 4 OF CERTIFIED SURVEYS, PAGE 111, AS DOCUMENT NO. 43351.

ORDERED BY: RE/MAX GENEVA REALTY, LTD.
RT. 1, BOX 360
LAKE GENEVA, WISCONSIN
53147

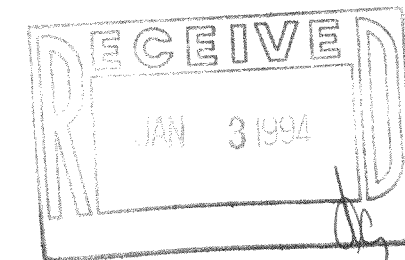

I HEREBY CERTIFY THAT I HAVE SURVEYED THE ABOVE DESCRIBED PROPERTY AND THAT THE ABOVE MAP IS A TRUE REPRESENTATION THEREOF AND SHOWS THE SIZE AND LOCATION OF THE PROPERTY, ITS EXTERIOR BOUNDARIES, THE LOCATION OF ALL VISIBLE STRUCTURES AND DIMENSIONS OF ALL PRINCIPAL BUILDINGS THEREON, BOUNDARY FENCES, APPARENT EASEMENTS, ROADWAYS AND VISIBLE ENCROACHMENTS, IF ANY, TO THE BEST OF MY KNOWLEDGE AND BELIEF.

THIS SURVEY IS MADE FOR THE USE OF THE PRESENT OWNERS OF THE PROPERTY AND ALSO THOSE WHO PURCHASE, MORTGAGE OR GUARANTEE THE TITLE THERETO WITHIN ONE (1) YEAR FROM DATE HEREOF.

Robert M. Baerenwald
ROBERT M. BAERENWALD
WISCONSIN REGISTERED LAND SURVEYOR, S-1508

DATE Dec. 1, 1993 JOB NO. 1282

NOTE: THIS IS NOT A CERTIFIED COPY UNLESS SEALED.

