


HAROLD H. KOLB
REGISTERED PROFESSIONAL LAND SURVEYOR
LAKE GENEVA, WISCONSIN



Scale 1" = 30'

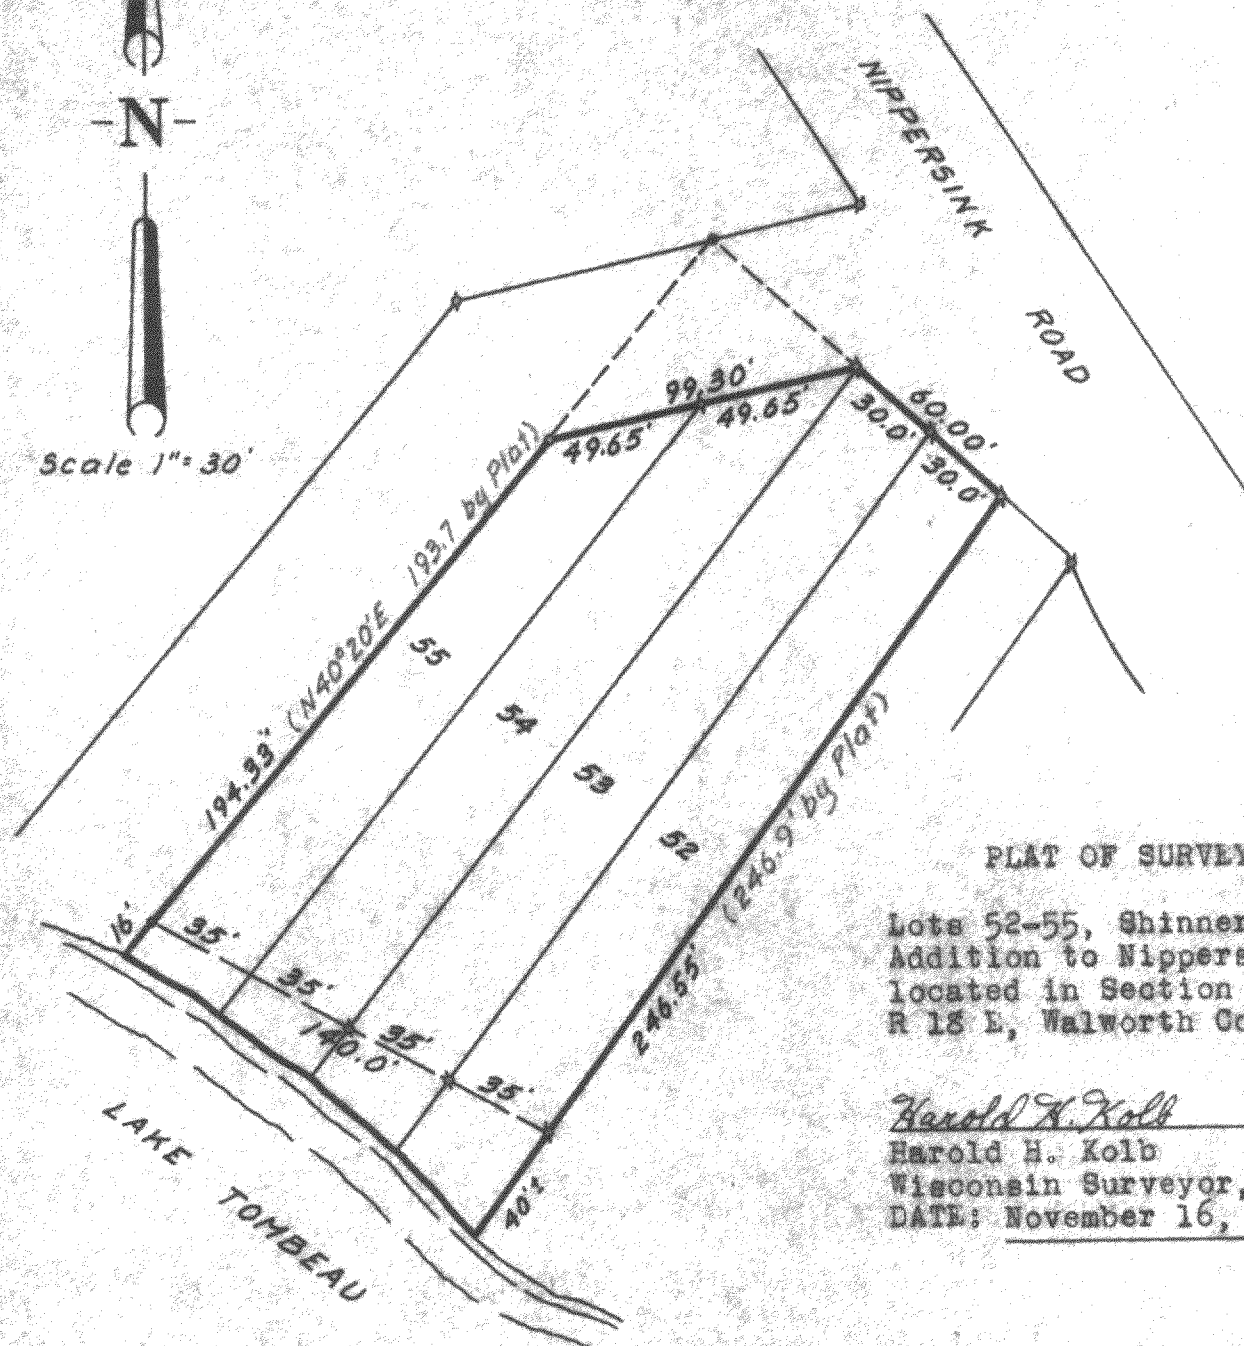

PLAT OF SURVEY OF

Lots 52-55, Shinner's 8th
Addition to Nippersink Park,
located in Section 24, T 1 N,
R 18 E, Walworth County, Wis.

Harold H. Kolb

Harold H. Kolb
Wisconsin Surveyor, B-187
DATE: November 16, 1963

- - Conc. Monument Found
- ◊ - Iron Pipe Found
- - Iron Pipe Placed

118-131