

LOT 38, NIPPERSINK HIGHLANDS, A SUBDIVISION LOCATED IN THE NE 1/4 OF THE NE 1/4 AND IN THE NW 1/4 OF THE NE 1/4 OF SECTION 24, BEING IN GOVERNMENT LOT 1 OF SECTION 24, TOWN 9 NORTH, RANGE 18 EAST, TOWN OF BLOOMFIELD, WALWORTH COUNTY, WISCONSIN.

BEARING DATUM IS THAT OF RECORDED PLAT.


O = IRON PIPE STAKE FOUND.



This survey is made for the exclusive use of the present owners of the property, and also those who purchase, mortgage, or guarantee the title thereto, within one year from date hereof,

John F. Degen, Land Surveyor's 242

RE-SURVEY 2-5-87
RE-SURVEY 3-18-94

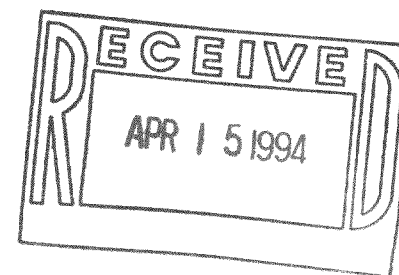

MNH-38

118-1316