


HAROLD E. KOLB
REGISTERED PROFESSIONAL LAND SURVEYOR
LAKE GENEVA, WISCONSIN

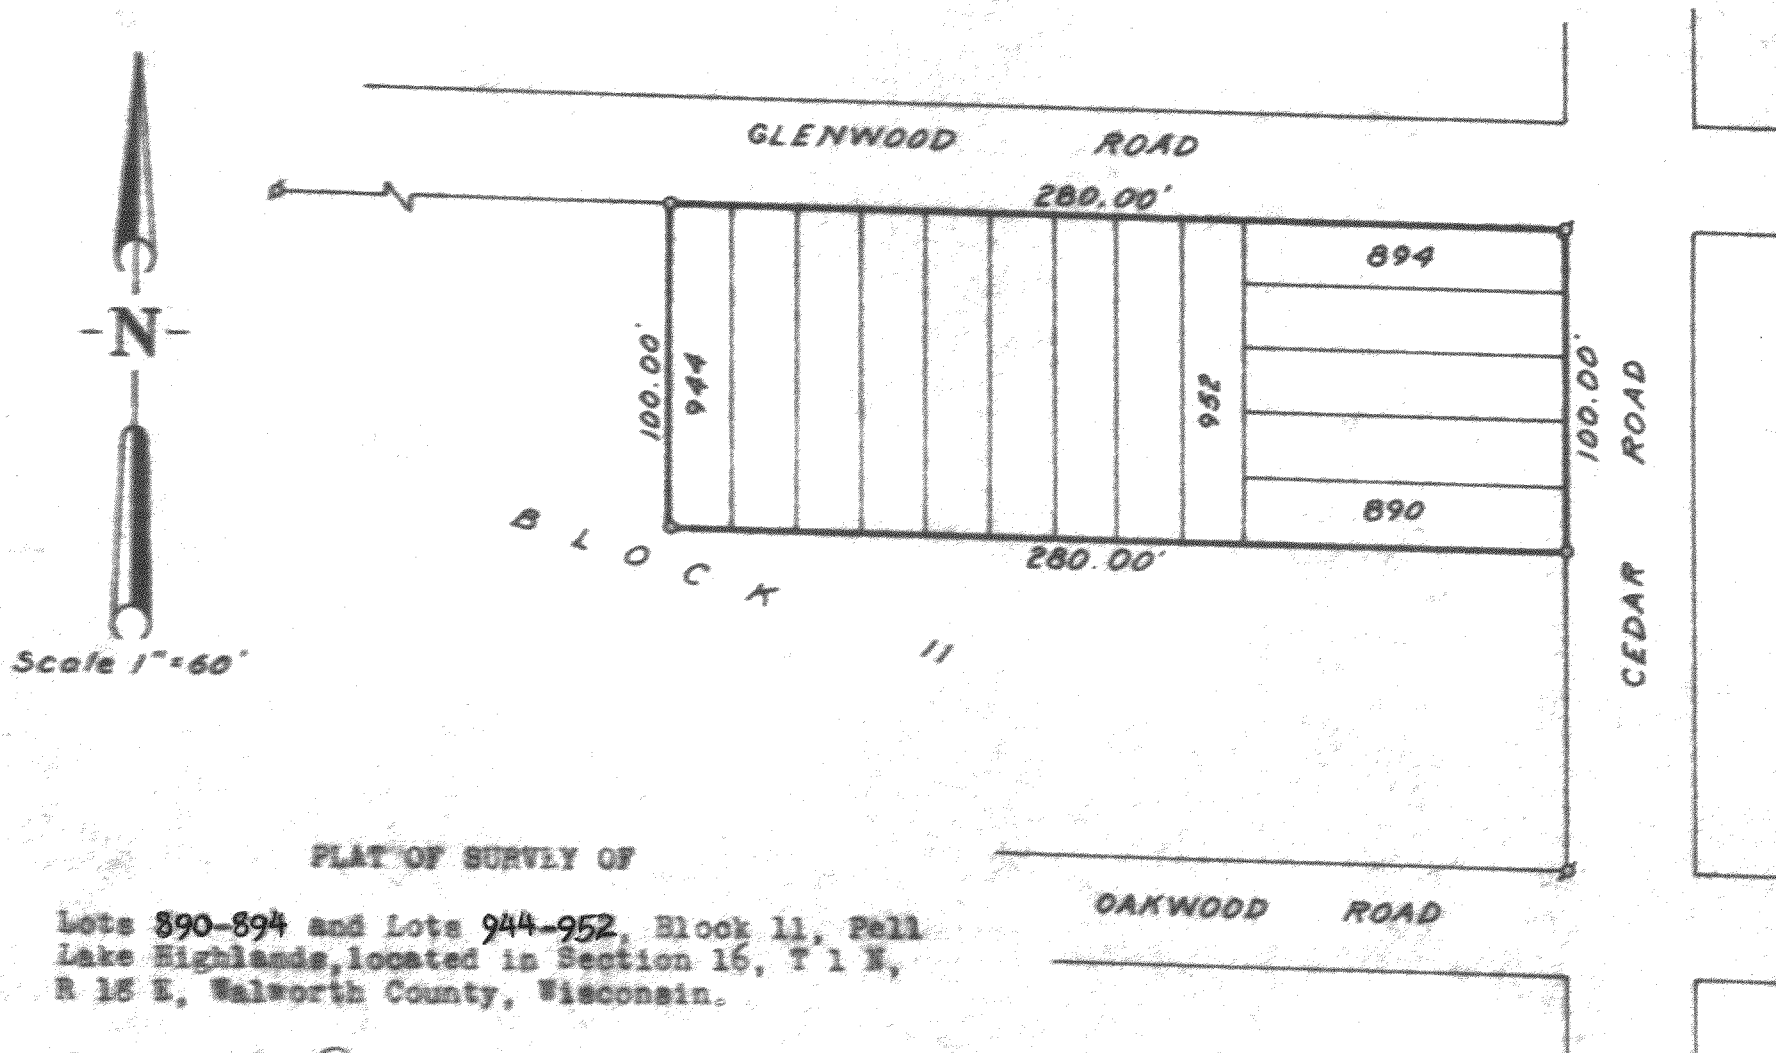

PLAT OF SURVLY OF

Lots 890-894 and Lots 944-952, Block 11, Fell
Lake Highlands, located in Section 16, T 1 N,
R 15 E, Walworth County, Wisconsin.

Harold E. Kolb

Harold E. Kolb, Wisconsin Surveyor, S-167

DATE: June 7, 1964

- - Iron Pipe Found
- o - Iron Pipe Placed

118-140