


PHONE 414-537-4874  
FAX 414-537-4221

Lot 12, Block 3 of ROSE NIPPERSINK GARDENS, being a subdivision located in the Southeast Quarter and the Southwest Quarter of the Southeast Quarter in Section 24, Township 1 North, Range 18 East of the 4th Principal Meridian, Township of Bloomfield, County of Walworth, State of Wisconsin.

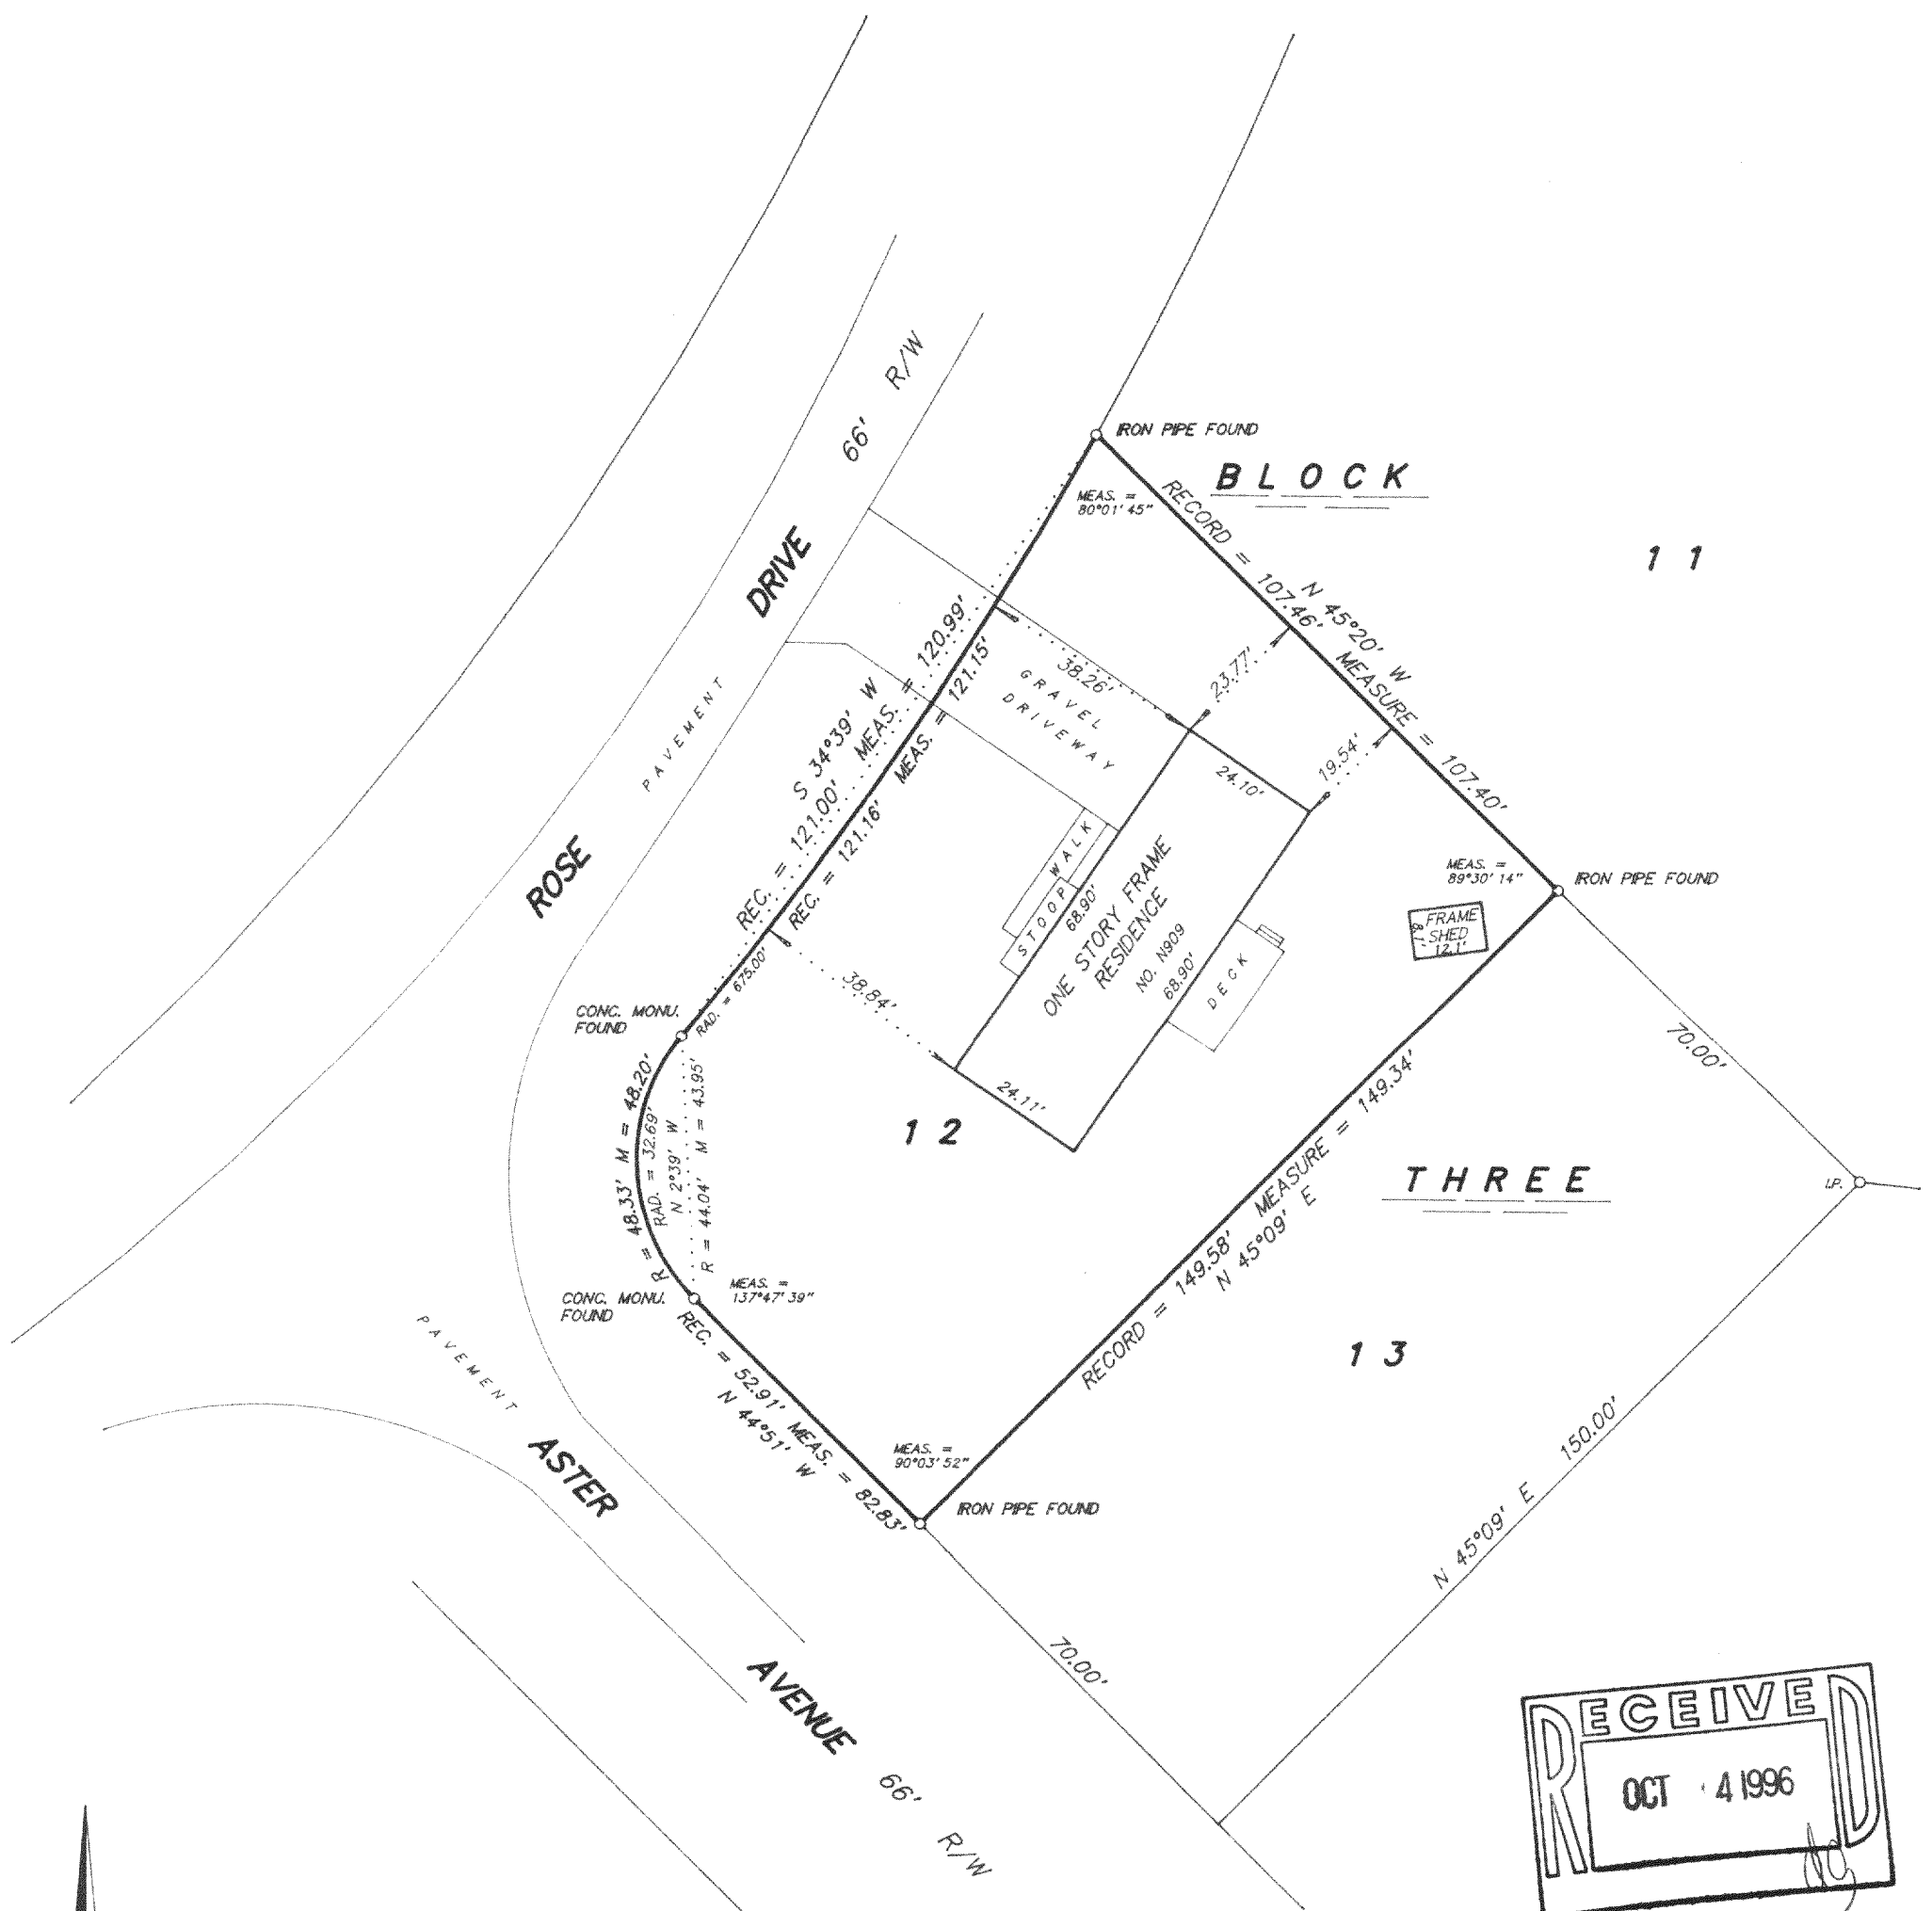

JOB NO. 9 6 3 1 4

Mark A. Bolender  
Wisconsin Registered Land Surveyor S - 1784

RECEIVED  
OCT 4 1996

MRNG-23  
118-1504