

PLAT OF SURVEY
OF

LOTS 3226 THROUGH 3232, IN BLOCK 47 OF SECTION 2 OF PELL LAKE SUBDIVISION, LOCATED IN THE TOWN OF BLOOMFIELD, COUNTY OF WALWORTH, STATE OF WISCONSIN.

FOR: PASCENTE

SCALE 1" = 30'

o = IRON PIPE SET.


σ = IRON PIPE FOUND.

I have surveyed the above-described property, and the map hereon is a true representation thereof and shows the size and location of the property, its exterior boundaries, the location and dimensions of all visible structures thereon, fences, apparent easements and roadways and visible encroachments, if any.


This survey is made for the exclusive use of the present owners of the property, and also those who purchase, mortgage, or guarantee the title thereto, within one year from date hereof.

Dated at Burlington, this 27th day,
of May 1996

John F. Degen
John F. Degen, Land Surveyor S 2120
589 N. Pine St. Burlington, WI 53105

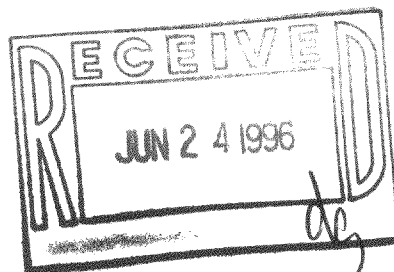

ASTER ROAD.

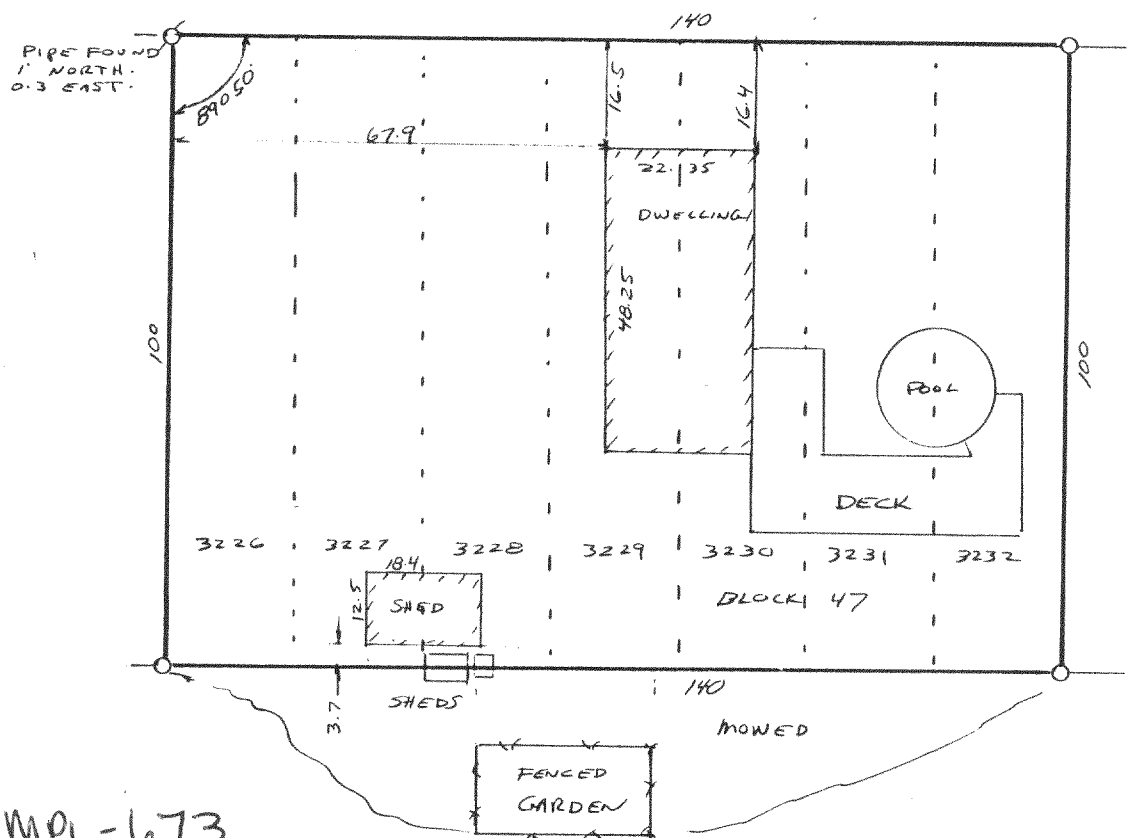

MPL-673
118-1530

19-A-1 #19