


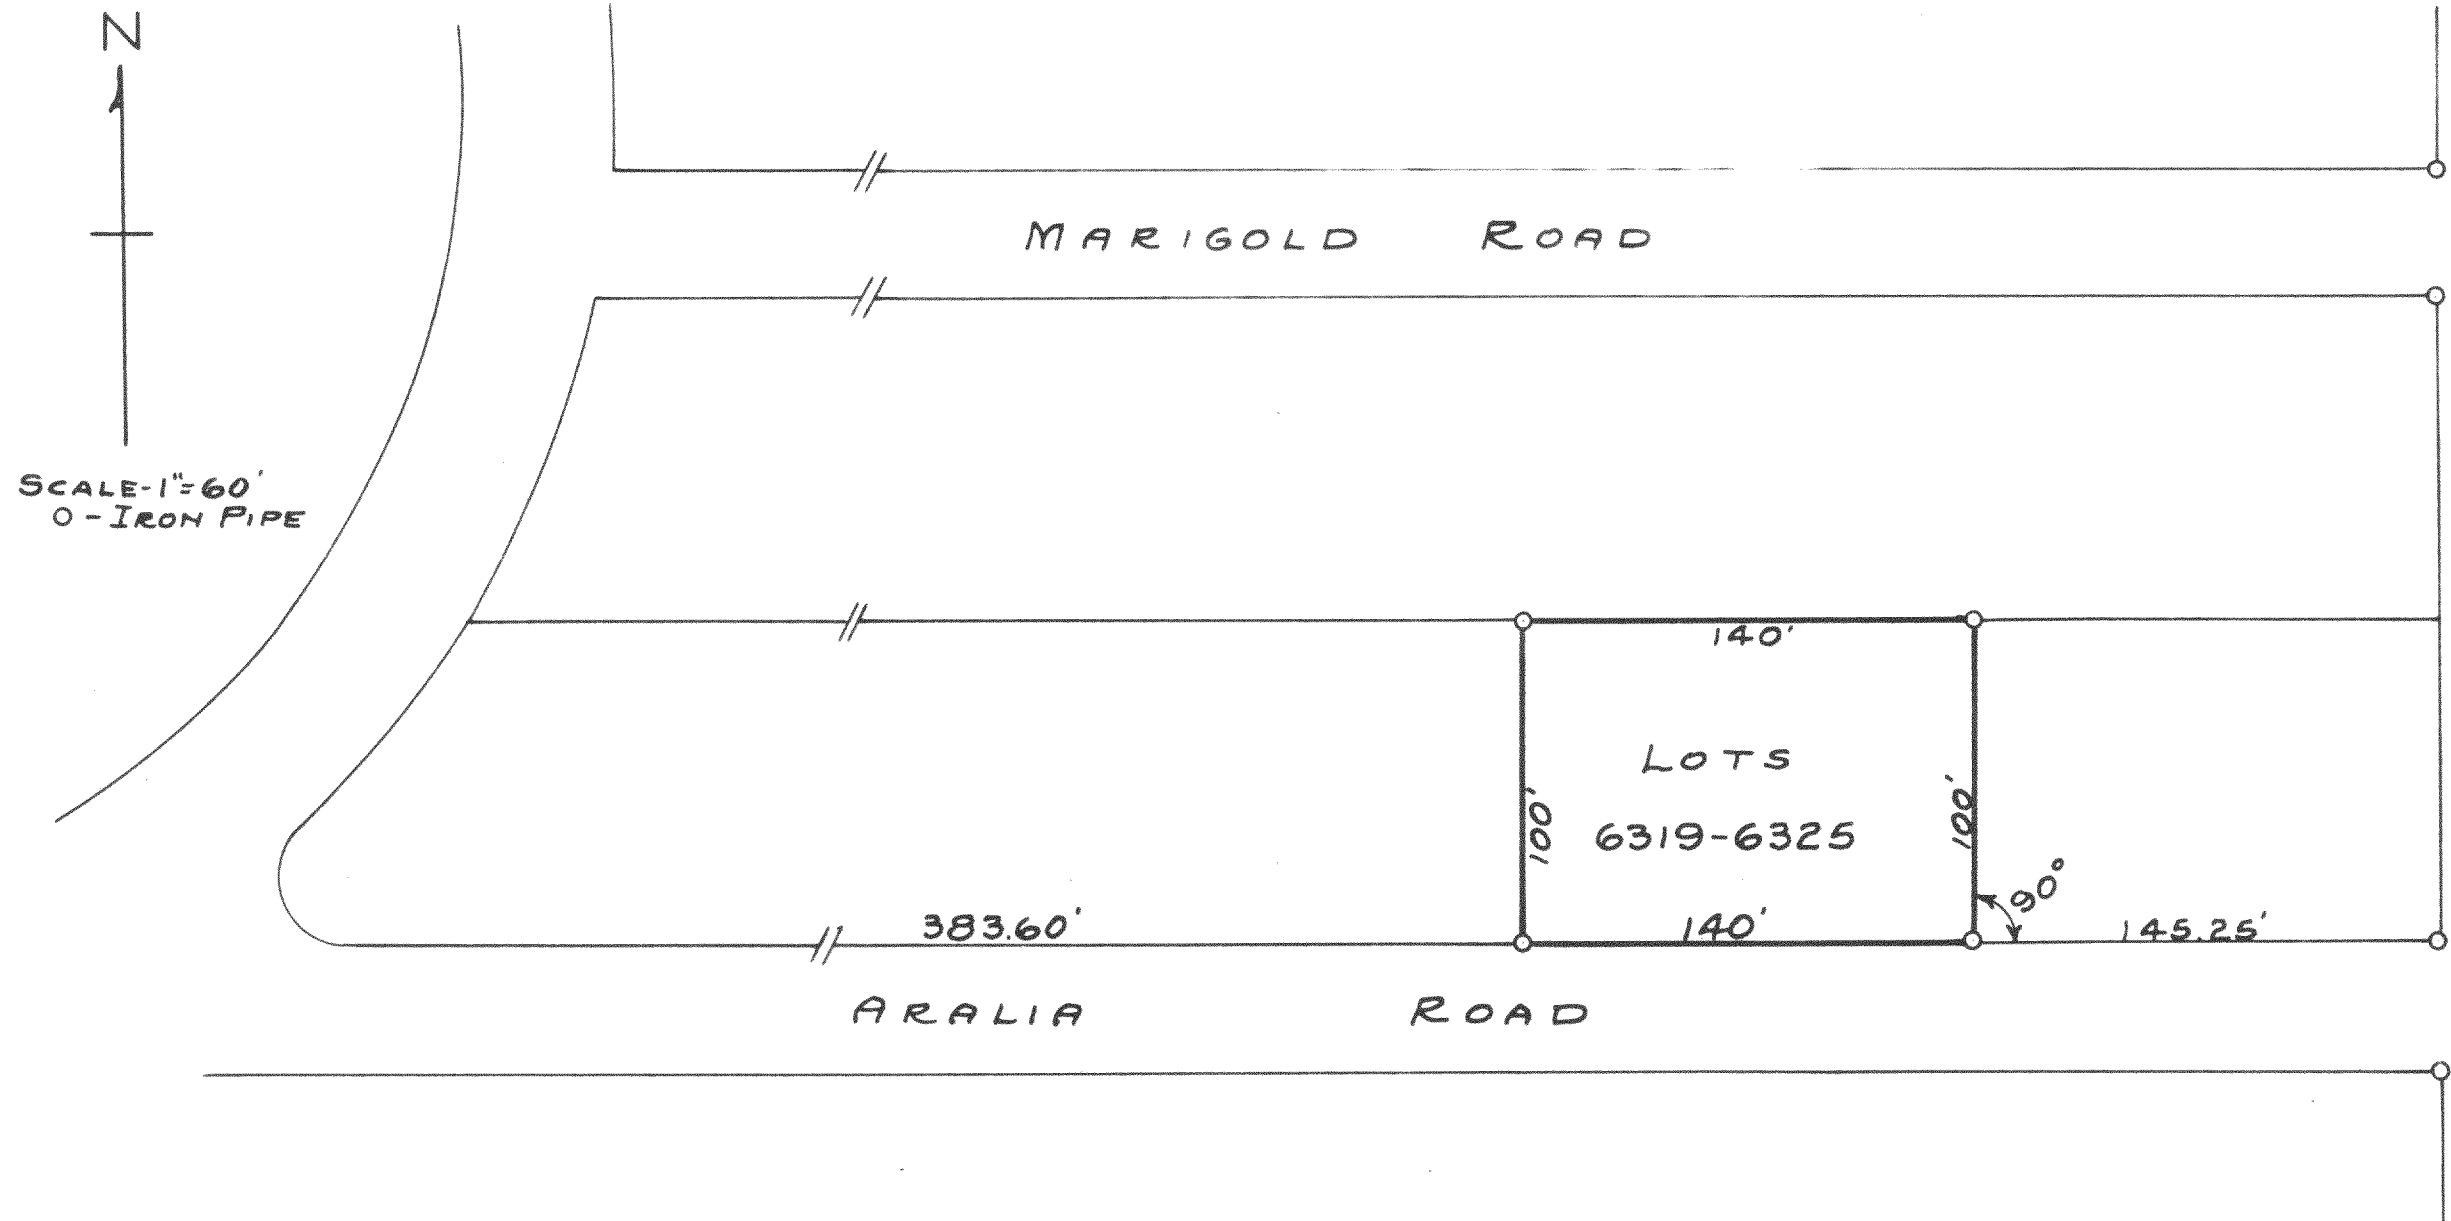

PLAT OF SURVEY OF LOTS 6319-6325, LOCATED
IN SECTION 4 OF PELL LAKE, WALWORTH
COUNTY, WISCONSIN.

OCT. 21, 1946

Lloyd L. Jensen
COUNTY SURVEYOR

118-16-1