


HAROLD H. KOLB

REGISTERED PROFESSIONAL LAND SURVEYOR
LAKE GENEVA, WISCONSIN

GREEN

ROAD

JASMINE

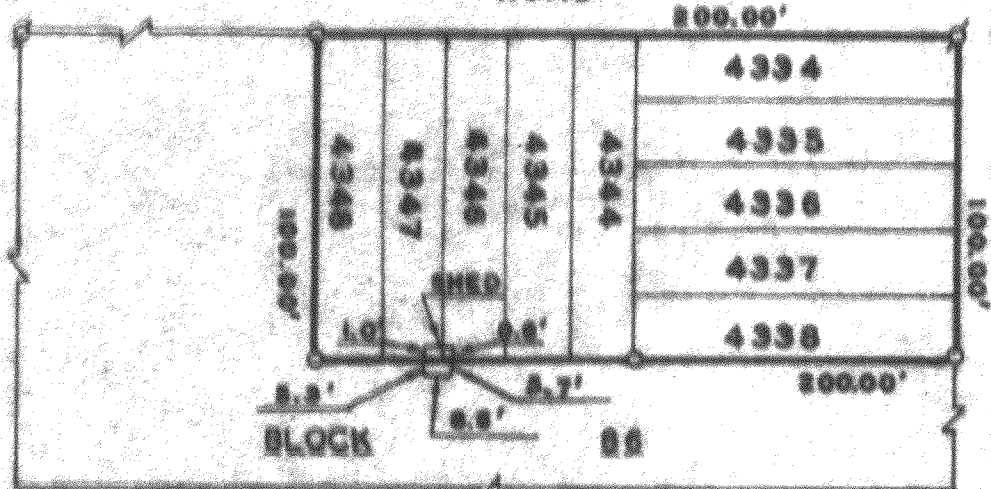

FLORENCE

ROAD

ROAD

PLAT OF SURVEY OF

Lots 4334-4338 and 4344-4348, Block 86,
Pell Lake, a subdivision located in T 1 N,
R 16 E, Walworth County, Wisconsin.

N



LEGEND

- ⊙ = IRON PIPE FOUND
- = IRON PIPE PLACED
- = CONCRETE MONUMENT
- ⋈ = SPIKE

SCALE: 1"=60'

I, HAROLD H. KOLB, DO HEREBY CERTIFY THAT I HAVE
SURVEYED THE PROPERTY HEREON DESCRIBED ACCORDING
TO THE OFFICIAL RECORDS, AND THAT THE PLAT HEREON
IS A CORRECT REPRESENTATION OF THE LOT LINES.

Harold H. Kolb

HAROLD H. KOLB

WISCONSIN REGISTERED LAND SURVEYOR, S-187

DATE July 17, 1965

118-166

1-18-701