


DEGEN, FOAT SURVEYING ASSOCIATES

100 SOUTH SECOND STREET
WATERFORD, WISCONSIN
(414)534-5404 (FAX)534-2022

975132
975132S1.DWG

PLAT OF SURVEY


LOTS 1 THRU 5, BLOCK 1, PELL LAKE HIGHLANDS, BEING A SUBDIVISION
LOCATED IN SECTION 16, TOWN 1 NORTH, RANGE 18 EAST, OF THE FOURTH
PRINCIPAL MERIDIAN, TOWN OF BLOOMFIELD, WALWORTH COUNTY, WISCONSIN.

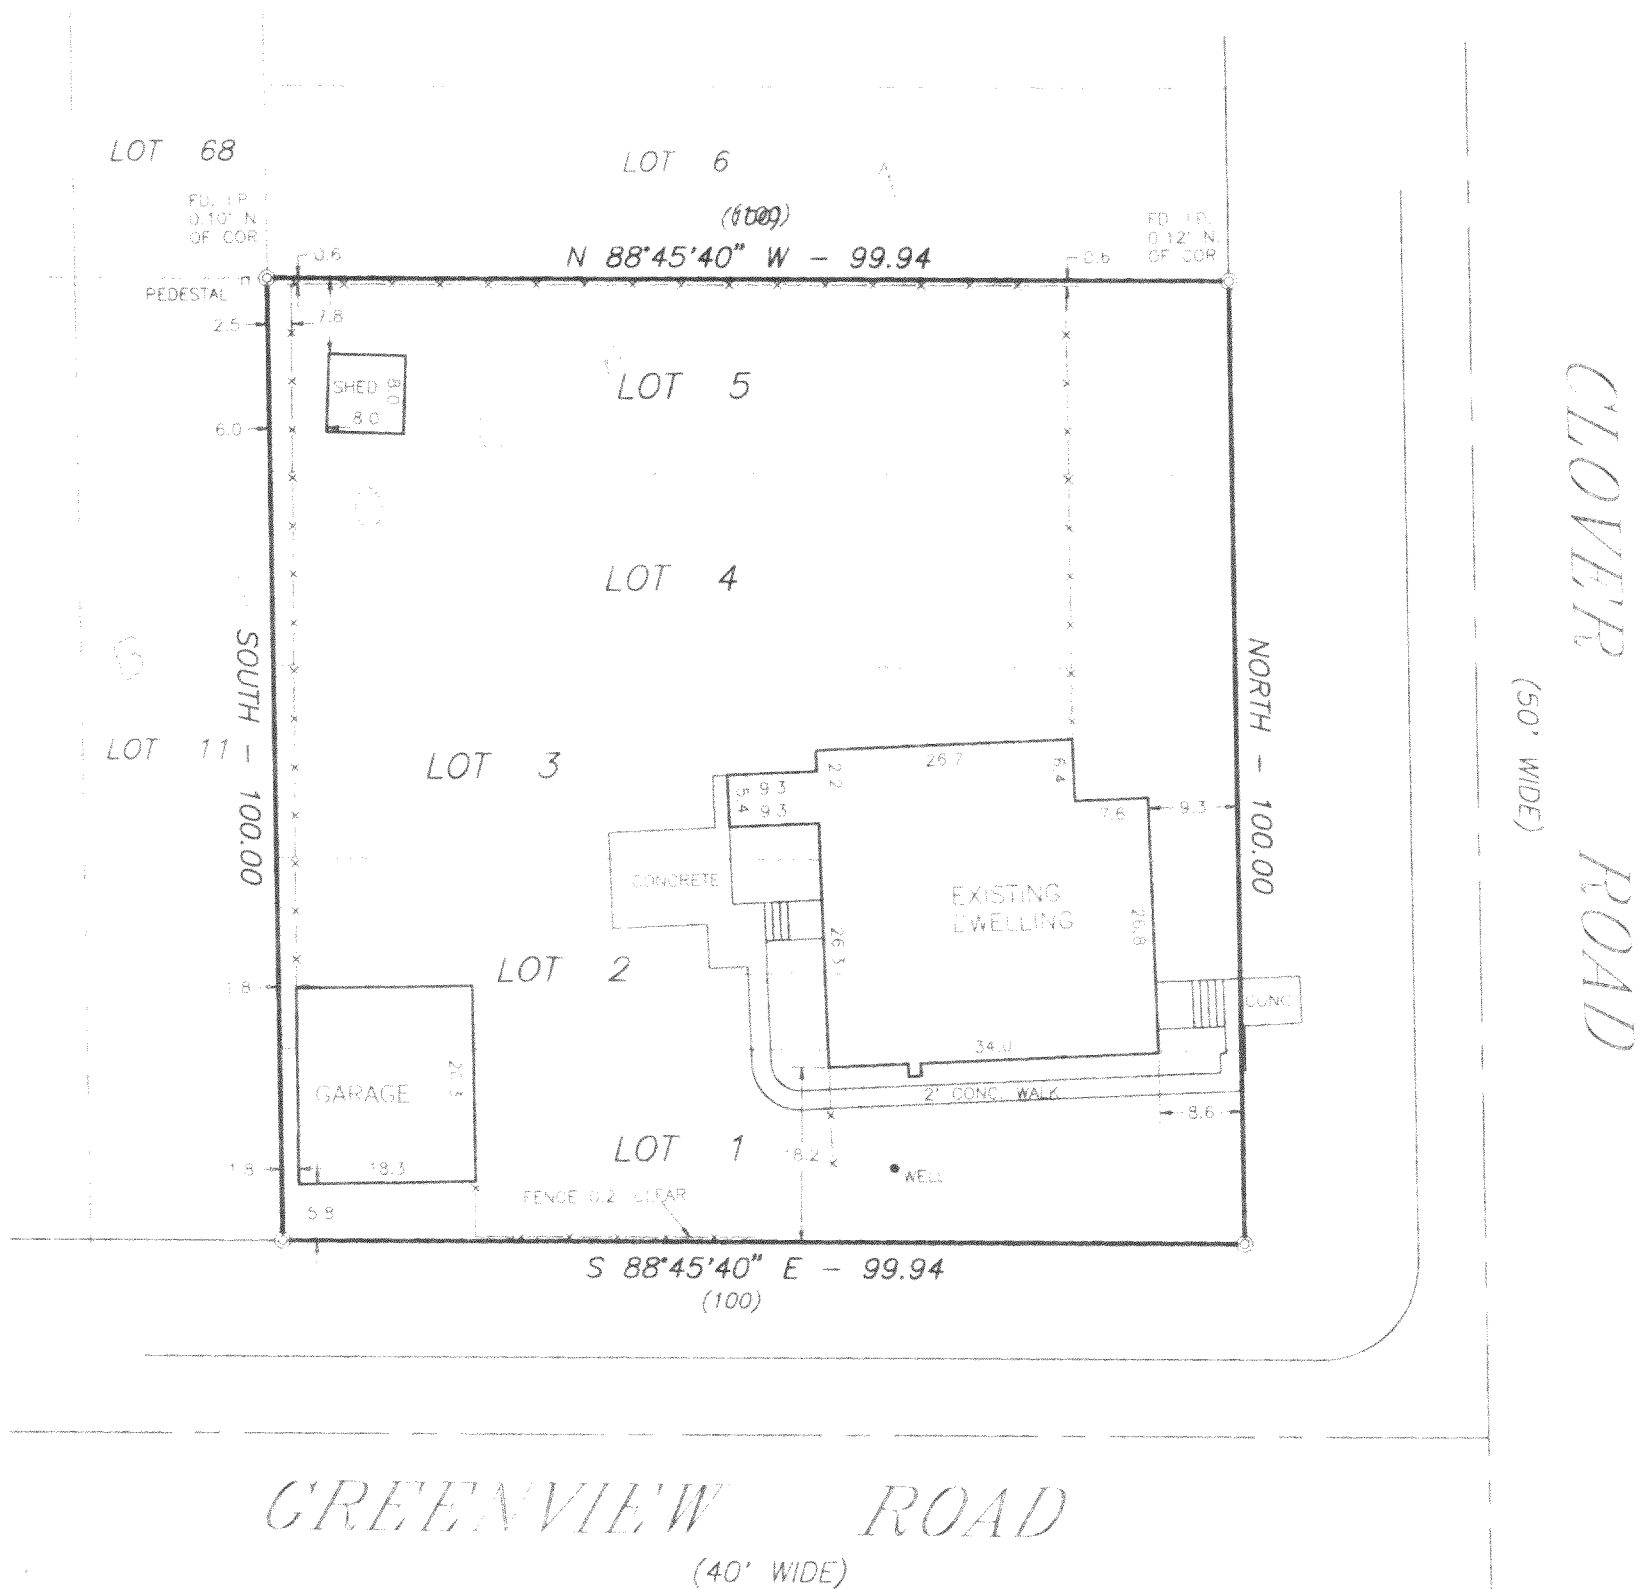

LEGEND

- + - CROSS CUT IN CONCRETE
- o - PK NAIL
- ⊙ - FOUND IRON PIPE
- - FOUND IRON ROD
- - SET IRON PIPE
- - WOOD FENCE
- () - RECORDED AS

SURVEYED FOR: DEBBIE McNICHOLS-SARNA
CENTURY 21 - ZENK REALTY
100 ELIZABETH LANE
GENOA CITY, WI 53128

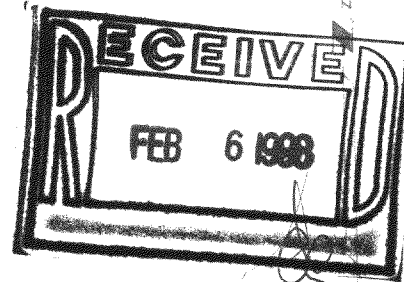

SCALE: 1" = 20'

BEARINGS ARE BASED ON THE WEST LINE OF
CLOVER ROAD WHICH WAS ASSUMED AS NORTH.

HEREBY CERTIFY THAT I HAVE SURVEYED THE ABOVE DESCRIBED PROPERTY AND THE ABOVE MAP IS A TRUE REPRESENTATION THEREOF
AND SHOWS THE SIZE AND LOCATION OF THE PROPERTY, THE LOCATION OF ALL VISIBLE STRUCTURES AND DIMENSIONS OF ALL PRINCIPAL
BUILDINGS THEREON, BOUNDARY FENCES, APPARENT EASEMENTS, ROADWAY AND VISIBLE ENCROACHMENTS, IF ANY.

THIS SURVEY IS MADE FOR THE PRESENT OWNERS OF THE PROPERTY, AND ALSO THOSE WHO PURCHASE OR GUARANTEE THE TITLE THEREIN
WITHIN (1) YEAR FROM THE DATE HEREOF.

DATED AT: WATERFORD THIS 15TH DAY OF DECEMBER 97

RECERTIFIED:

Handwritten signature: Gary B. Foat

118-1698
MPLH-1