

PLAT OF SURVEY

PATHFINDER SURVEYING
FORMERLY KOLB LAND CONSULTING
929 WILLIAMS STREET LAKE GENEVA, WI. 53147
(414) 248-3697


ORDERED BY:

AMY C. BATES
ATTORNEY AT LAW
397 LAKE ST.
ANTIOCH, IL. 60002

DATE: 8 / 26 / 1998

DESCRIPTION:

LOTS 8365-8367 AND LOTS 8393- 8397 INCLUSIVE BLOCK 177 PELL LAKE SUBDIVISION A SUBDIVISION LOCATED IN T.1.N. , R.18.E. , WALWORTH COUNTY , WISCONSIN.

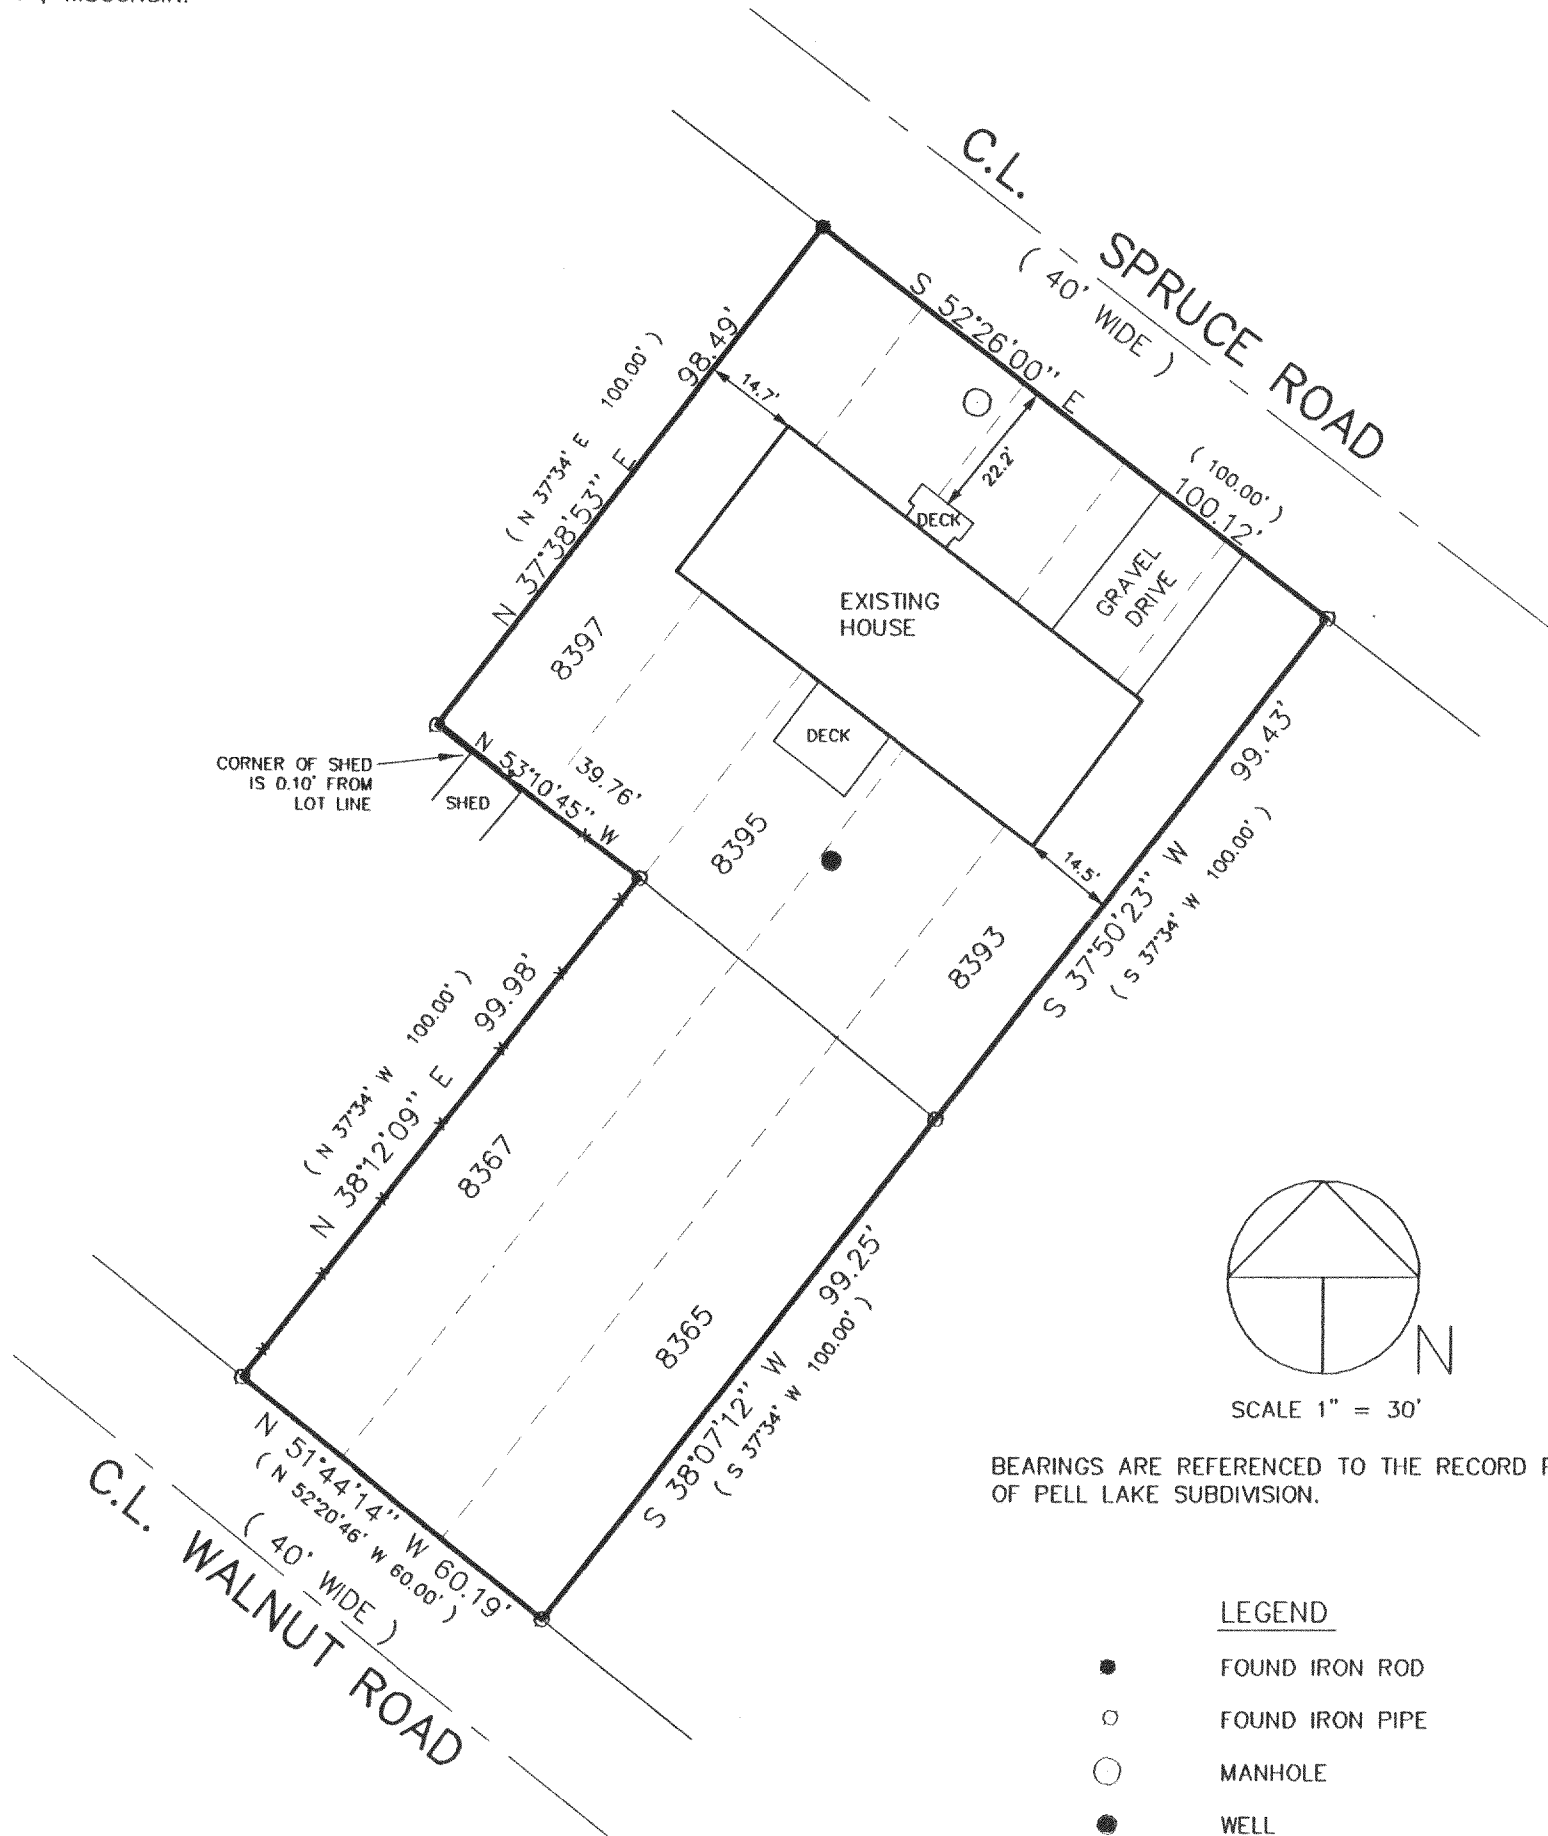

BEARINGS ARE REFERENCED TO THE RECORD PLAT OF PELL LAKE SUBDIVISION.



LEGEND

- FOUND IRON ROD
- FOUND IRON PIPE
- MANHOLE
- WELL
- (XXXX) RECORDED AS

THE ABOVE MAP IS A TRUE REPRESENTATION THEREOF AND SHOWS THE SIZE AND LOCATION OF ALL THE PROPERTY, EXTERIOR BOUNDARIES, THE LOCATION OF ALL VISIBLE BOUNDARY FENCES, APPARENT EASEMENTS, ROADWAYS AND VISIBLE ENCROACHMENTS, IF ANY

THIS SURVEY IS MADE FOR THE USE OF THE PRESENT OWNERS OF THE PROPERTY, AND ALSO THOSE WHO PURCHASE, MORTGAGE OR GUARANTEE TITLE THERETO WITHIN ONE (1) YEAR FROM DATE HERETO.

John P. Krott
JOHN P. KROTT, R.L.S. 2258

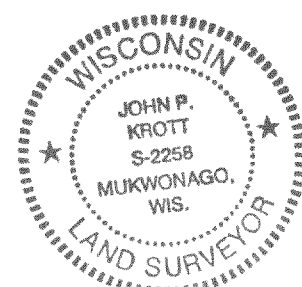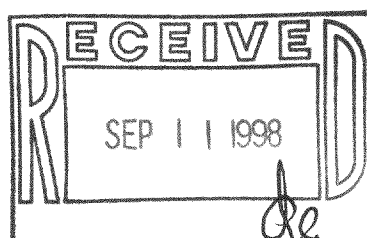

NOTE: THIS IS NOT A CERTIFIED COPY UNLESS SEAL IS IN RED.

JOB NUMBER: 98156 1-18-MPL-01676

MPL-1676

118-1754