PLAT OF SURVEY

PATHFINDER SURVEYING

FORMERLY KOLB LAND CONSULTING 929 WILLIAMS STREET LAKE GENEVA, WI. 53147 (414) 248-3697


ORDERED BY: WALTER FITSCHEN

1397 BERNICE RD. PELL LAKE

DESCRIPTION: LOTS 419-425 AND 474-476

BLOCK 18 PELL LAKE HIGHLANDS, LOCATED IN SECTION 16, T1N, R18E WALWORTH COUNTY, WISCONSIN. DATE: 1/26/1999

C.L. HONEYSUCKLE ROAD (40' WIDE)

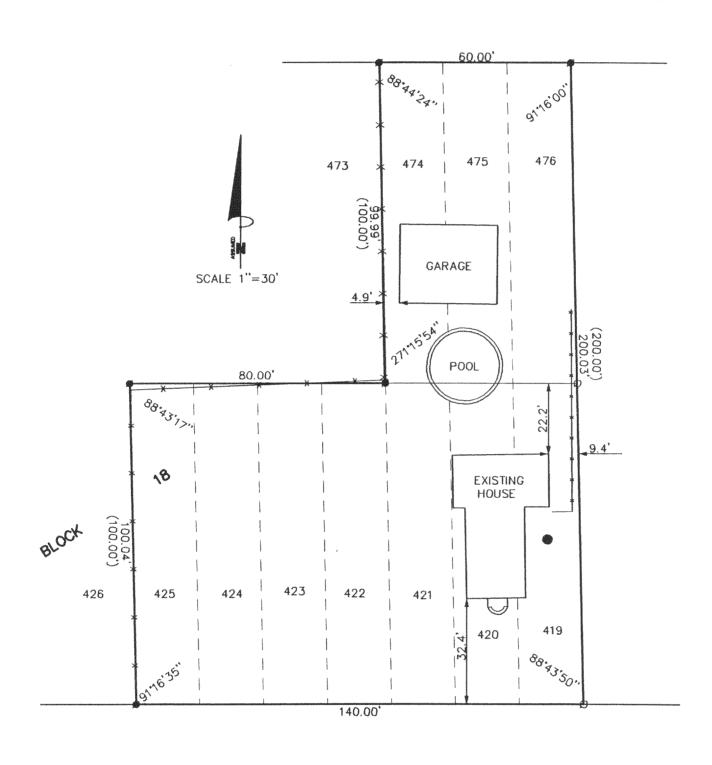

C.L. BERENICE ROAD (40' WIDE)

THE ABOVE MAP IS A TRUE REPRESENTATION THEREOF AND SHOWS THE SIZE AND LOCATION OF ALL THE PROPERTY, EXTERIOR BOUNDARIES, THE LOCATION OF ALL VISIBLE BOUNDARY FENCES, APPARENT EASEMENTS, ROADWAYS AND VISIBLE ENCROACHMENTS, IF ANY

THIS SURVEY IS MADE FOR THE USE OF THE PRESENT OWNERS OF THE PROPERTY, AND ALSO THOSE WHO PURCHASE, MORTGAGE OR GURANTEE TITLE THERETO WITHIN ONE (1) YEAR FROM DATE HERETO.

JOHN P. KROTT , R.L.S. 2258



- O FOUND IRON PIPE
- SET IRON PIPE

(XXX) RECORDED AS

- -X- FENCE
- WELL





NOTE: THIS IS NOT A CERTIFIED COPY UNLESS SEAL IS IN RED.

JOB NUMBER #99014 MPLH 00093