

# DEGEN, FOAT SURVEYING ASSOCIATES



100 SOUTH SECOND STREET  
WATERFORD, WISCONSIN  
(414)534-5404 (FAX)534-2022

982318  
982318S1.DWG

## PLAT OF SURVEY

LOTS 9733 THRU 9738, BLOCK 214, OF SECTION 7 OF PELL LAKE, A SUBDIVISION  
LOCATED IN SECTION 21, TOWN 1 NORTH, RANGE 18 EAST OF THE FOURTH  
PRINCIPAL MERIDIAN, TOWN OF BLOOMFIELD, WALWORTH COUNTY, WISCONSIN.

SURVEYED FOR: CATHY MEINEN  
7249 PRAIRIE ROAD  
ELKHORN, WI 53121

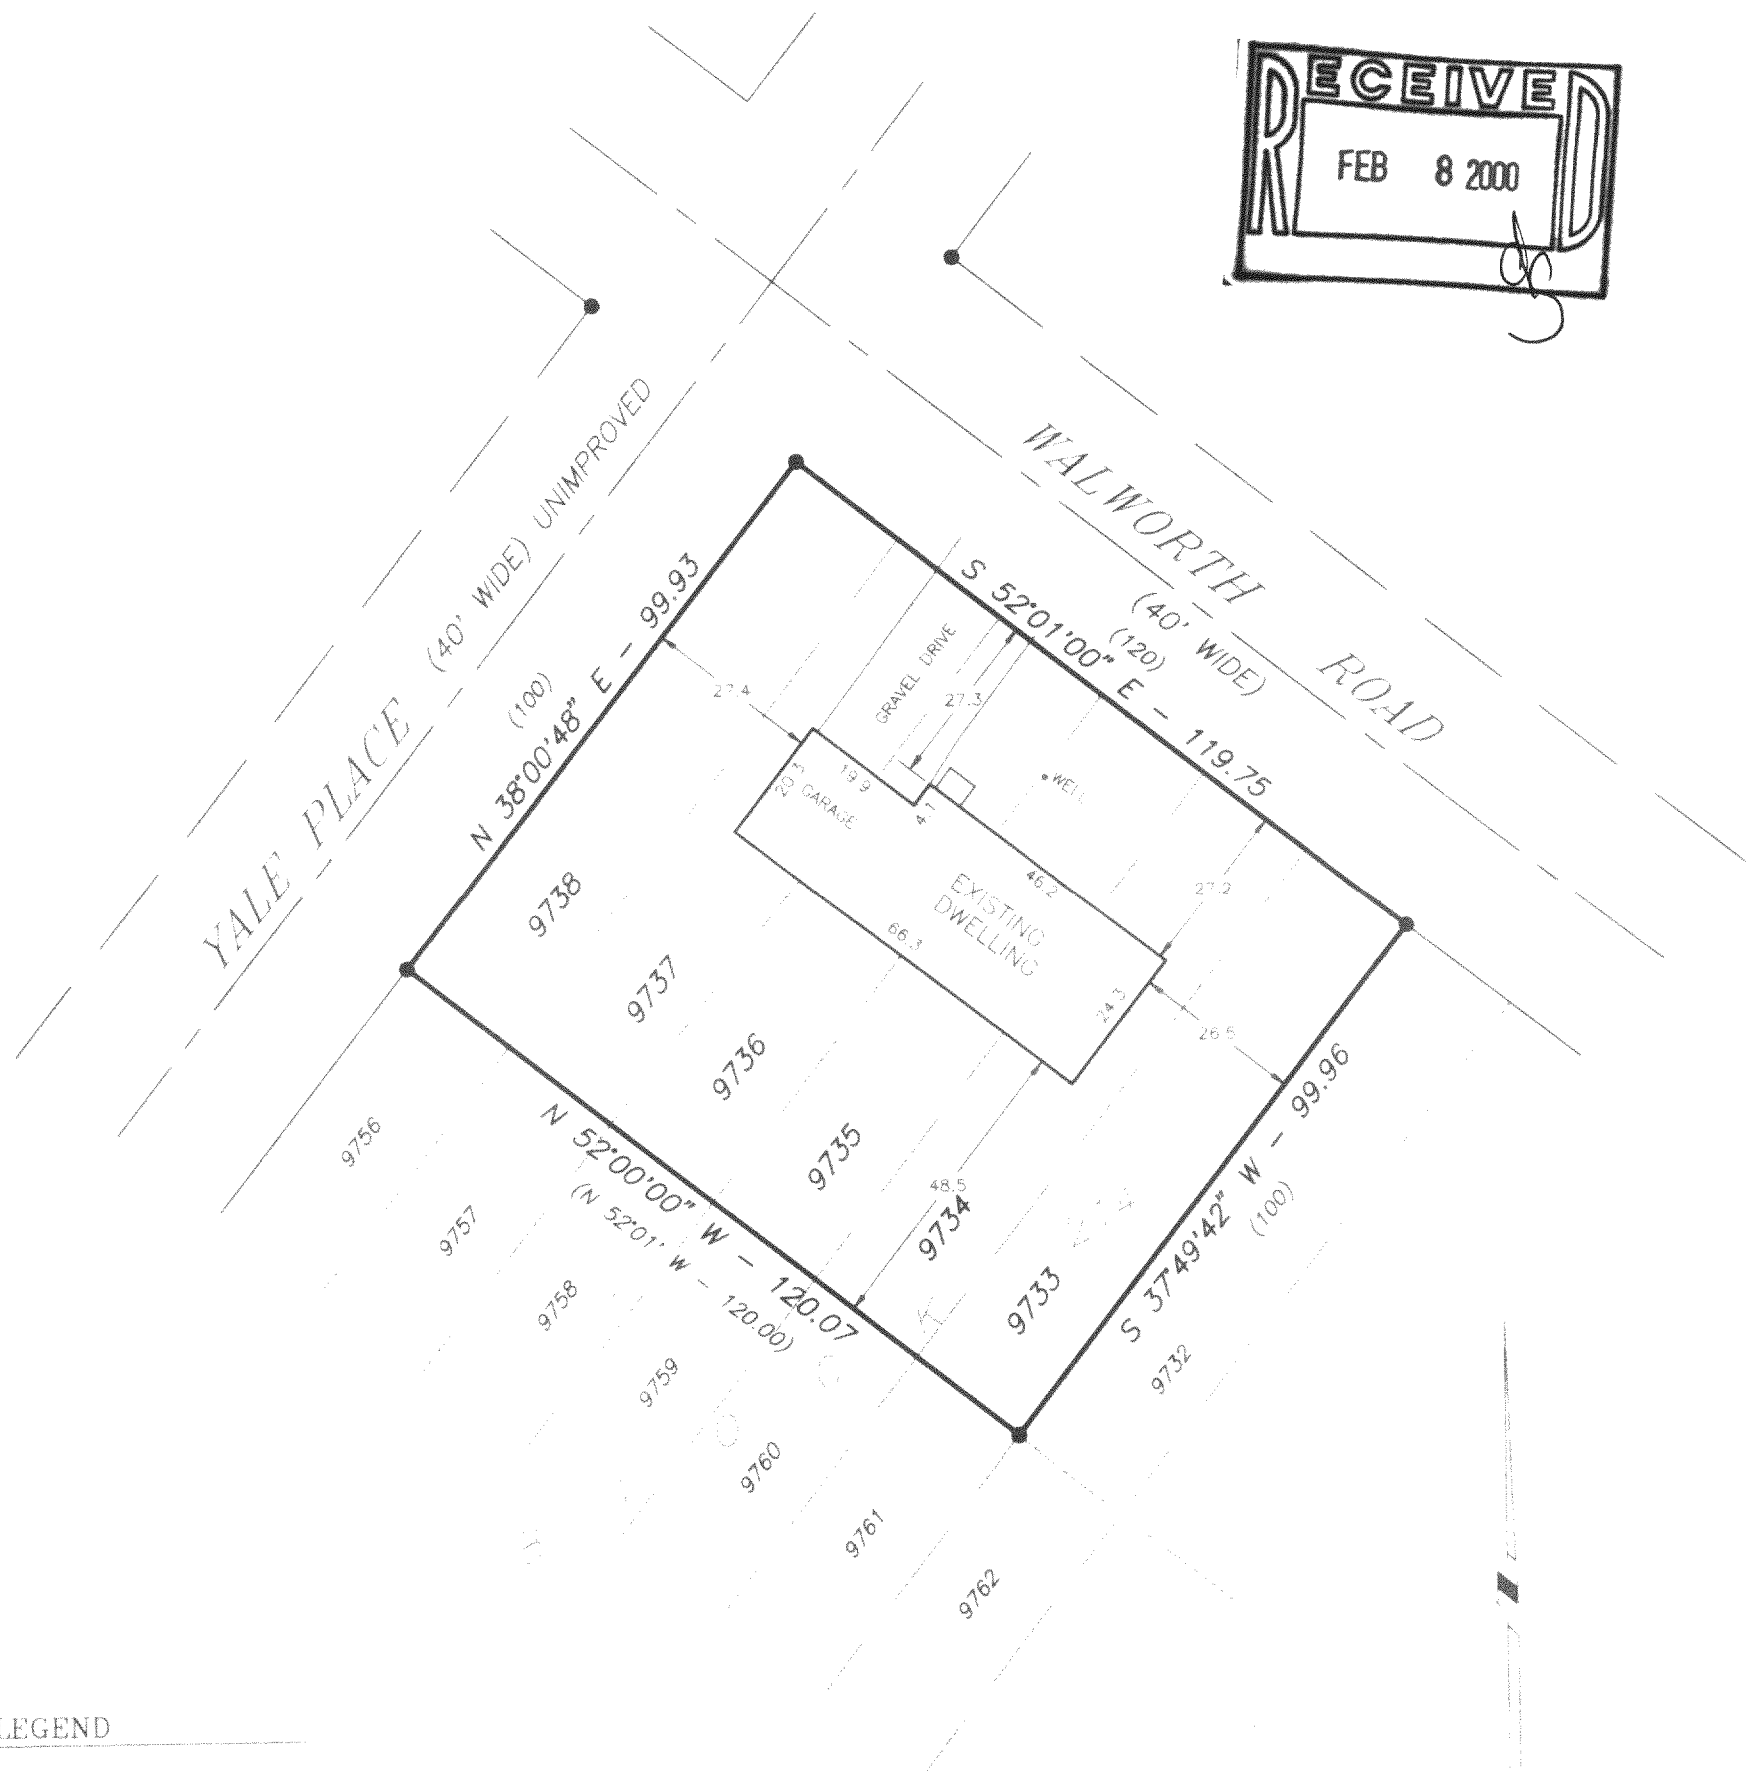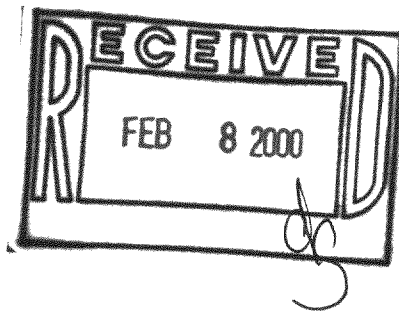

### LEGEND

● - FOUND IRON PIPE

SCALE: 1" = 30'

I HEREBY CERTIFY THAT I HAVE SURVEYED THE ABOVE DESCRIBED PROPERTY AND THE ABOVE MAP IS A TRUE REPRESENTATION THEREOF  
AND SHOWS THE SIZE AND LOCATION OF THE PROPERTY, THE LOCATION OF ALL VISIBLE STRUCTURES AND DIMENSIONS OF ALL PRINCIPAL  
BUILDINGS THEREON, BOUNDARY FENCES, APPARENT EASEMENTS, ROADWAY AND VISIBLE ENCROACHMENTS, IF ANY.

THIS SURVEY IS MADE FOR THE PRESENT OWNERS OF THE PROPERTY AND ALSO THOSE WHO PURCHASE, OR GUARANTEE THE TITLE THERE TO  
WITHIN (1) YEAR FROM THE DATE HEREOF

DATED AT WATERFORD THIS 21ST DAY OF AUGUST 1998

RECERTIFIED SEPT. 11, 1999

*James B. Foat*

MPL-1973

118-1911