
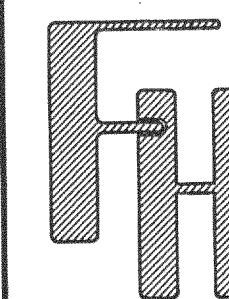


BOUNDARY & TOPOGRAPHIC SURVEY
TAX PARCEL B-36-8 & LOT 3 OF HABREL SUBDIVISION
LOCATED IN THE SOUTHWEST 1/4 OF SECTION 36, TOWN 1 NORTH, RANGE 18 EAST, TOWN
OF BLOOMFIELD & VILLAGE OF GENOA CITY, WALWORTH COUNTY, WISCONSIN

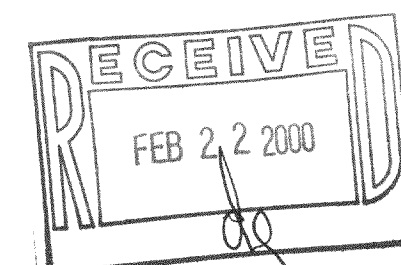

BOUNDARY & TOPOGRAPHIC
SURVEY

- WORK ORDERED BY -
JOHN ARNOW
N830 TAMARACK ROAD
PALMYRA, WI 53156

FARRIS, HANSEN & ASSOCIATES, INC.

ENGINEERING - ARCHITECTURE - SURVEYING

7 RIDGWAY COURT P.O. BOX 437
ELKHORN, WISCONSIN 53121


OFFICE: (262) 723-2098 FAX: (262) 723-5866

REVISIONS

PROJECT NO.
4608.00

DATE
01/17/2000

SHEET NO.
1 OF 1

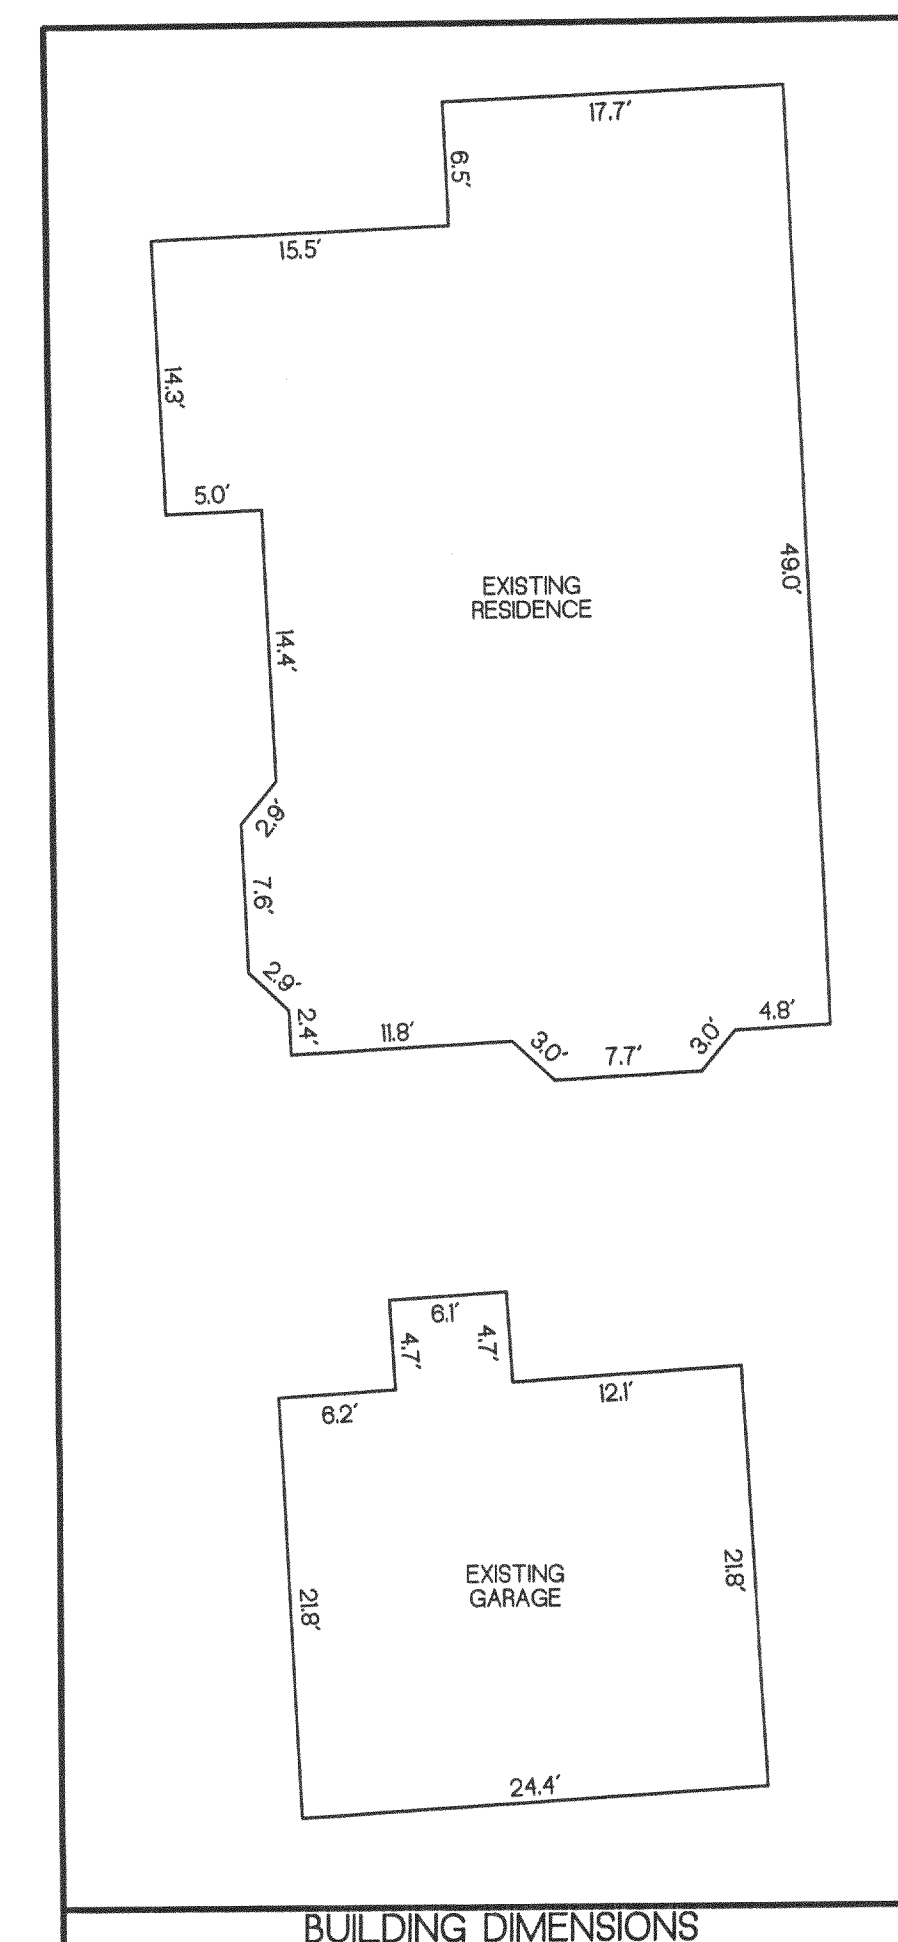

LEGAL DESCRIPTION FOR TAX PARCEL B-36-8
ALL THAT PART OF THE NORTH 1/2 OF THE SOUTHWEST 1/4 OF THE SOUTHWEST
1/4 OF SECTION 36, TOWN 1 NORTH, RANGE 18 EAST, WALWORTH COUNTY,
WISCONSIN, LYING SOUTH OF THE SOUTHERLY LINE OF WALWORTH STREET AND
WESTERLY OF THE WESTERLY LINE OF U.S. HIGHWAY 12.

NOTE: COPIES OF THIS MAP TO WHICH THE FOLLOWING CERTIFICATE
WILL APPLY SHOW THE SURVEYORS ORIGINAL SEAL AND SIGNATURE
IN RED INK. COPIES BY ANY OTHER MEANS MAY HAVE ALTERATIONS
WHICH DO NOT REPRESENT THE SURVEYORS WORK PRODUCT.

I HEREBY CERTIFY THAT THE ABOVE DESCRIBED PROPERTY HAS BEEN
SURVEYED UNDER MY DIRECTION AND THAT THE ABOVE MAP IS A TRUE
REPRESENTATION THEREOF AND SHOWS THE SIZE AND LOCATION OF
THE PROPERTY AND ITS EXTERIOR BOUNDARIES. THIS SURVEY IS MADE
FOR THE USE OF THE PRESENT OWNERS OF THE PROPERTY, AND ALSO
THOSE WHO PURCHASE, MORTGAGE, OR GUARANTEE THE TITLE
THEREOF WITHIN ONE YEAR FROM THE DATE HEREOF.

DATED: 1-18-2000

PETER S. GORDON R.L.S. 2101

MB-36-8
TH-3

118-1912

ASSIGNED WESTERLY LINE OF U.S. HIGHWAY 12
S 11°51'55" E

U.S. HIGHWAY 12
VARIABLE WIDTH

B-36-8
198,292 SQ. FT.

LOT 3
11,995 SQ. FT.

STERLING PARKWAY
66' WIDE R.O.W.

LEGEND

- = FOUND IRON PIPE STAKE
- ◇ = UTILITY POLE LOCATED
- = GUY WIRE LOCATED
- = UTILITY CONTROL BOX LOCATED
- = TRANSFORMER LOCATED
- ⊙ = WELL LOCATED
- XXXX = RECORDED AS

MAP SCALE IN FEET ORIGINAL 1" = 30'