

DEGEN, FOAT SURVEYING ASSOCIATES



100 SOUTH SECOND STREET
WATERFORD, WISCONSIN
(262)534-5404 (FAX)534-2022

004234
004234S1.DWG

PLAT OF SURVEY

LOTS 6375 THRU 6380, BLOCK 139 OF SECTION 4 OF PELL LAKE SUBDIVISION, LOCATED IN PART OF SECTION 15, TOWN 1 NORTH, RANGE 18 EAST, TOWN OF BLOOMFIELD, WALWORTH COUNTY, WISCONSIN.

SURVEY PREPARED FOR: RE/MAX SOUTHERN LAKES REALTY
112 ELIZABETH LANE
GENOA CITY, WI 53128

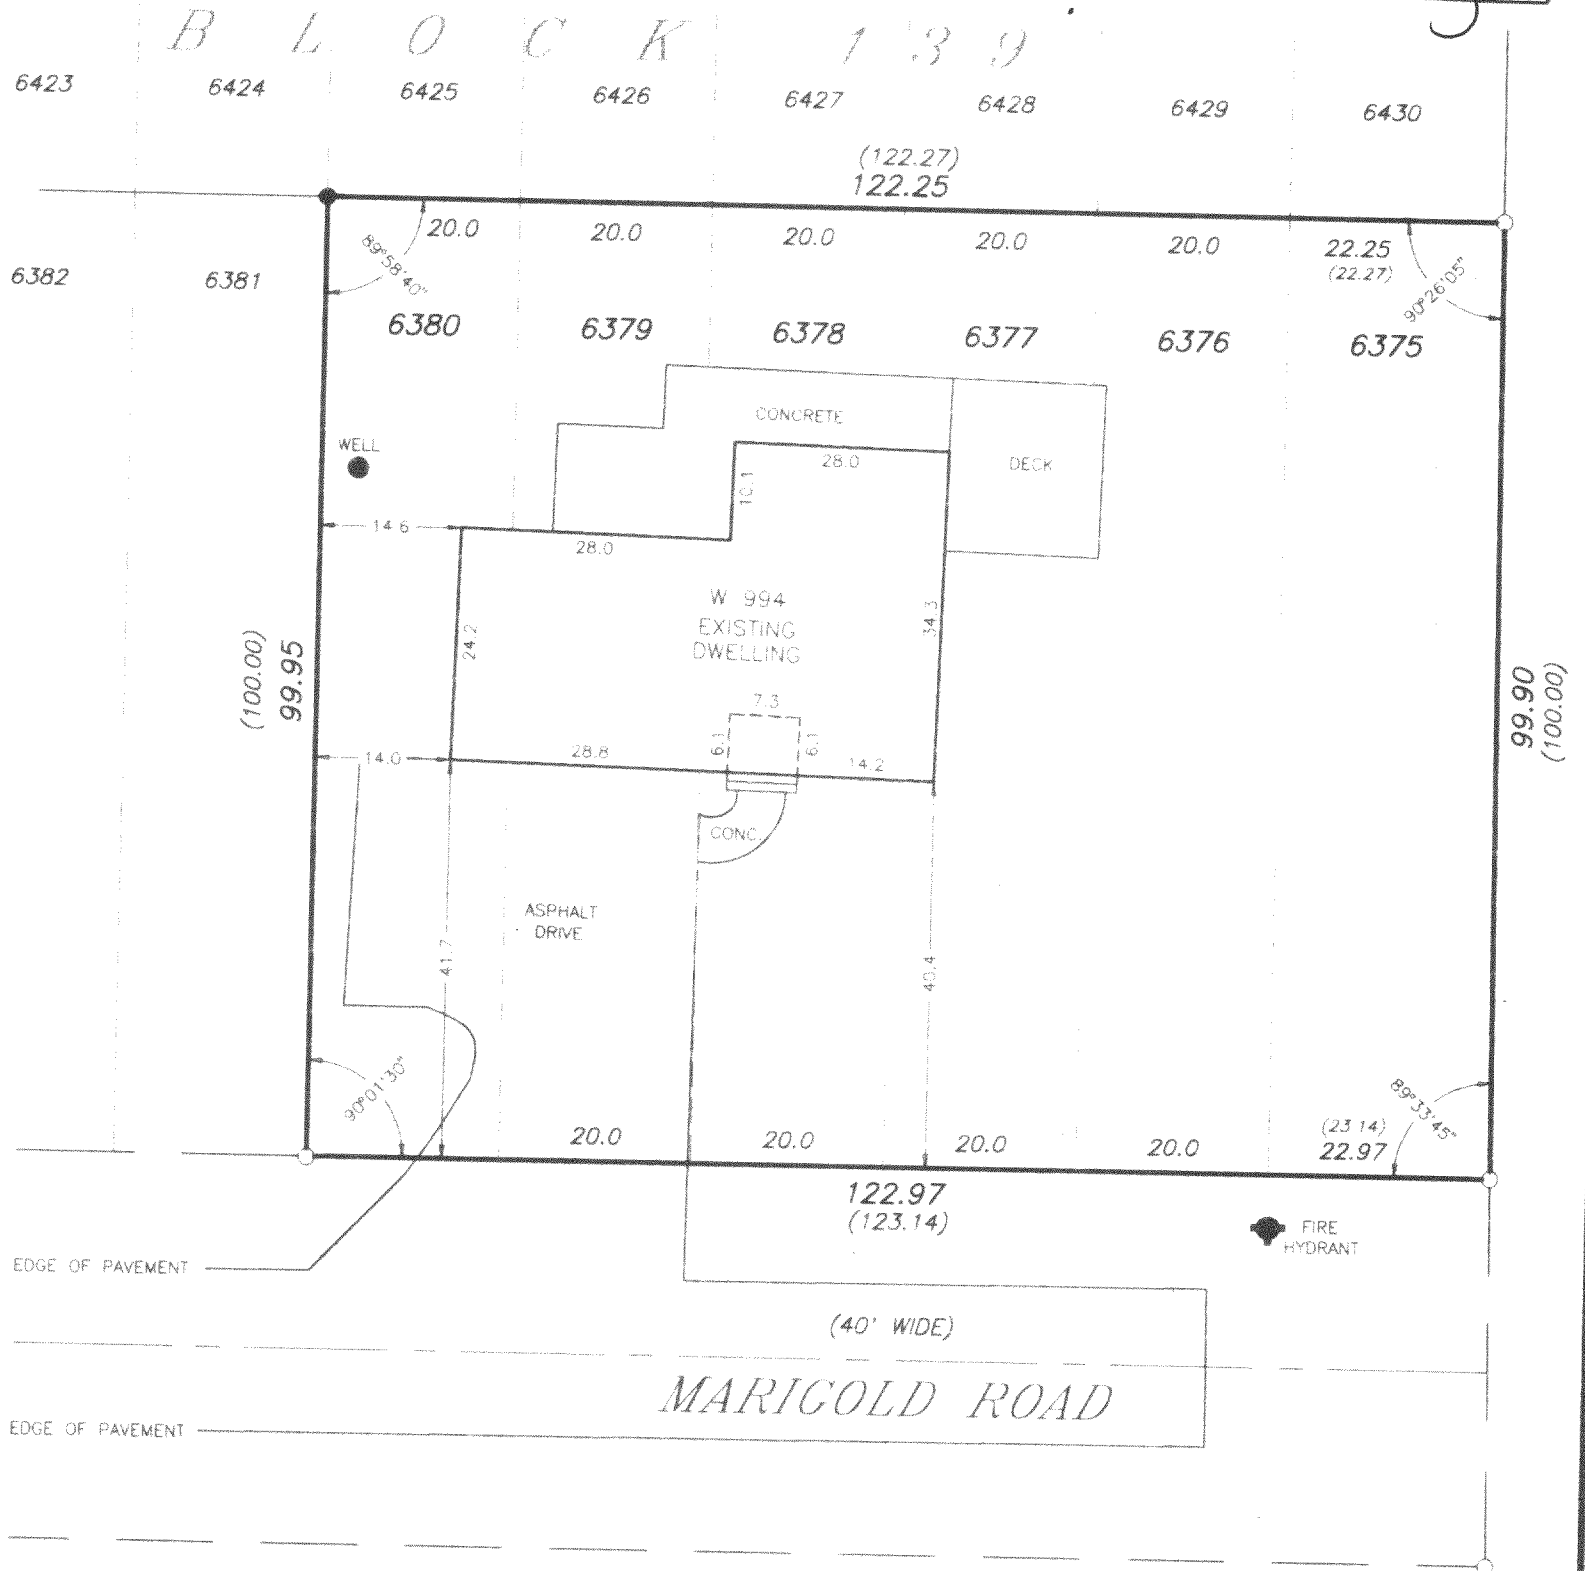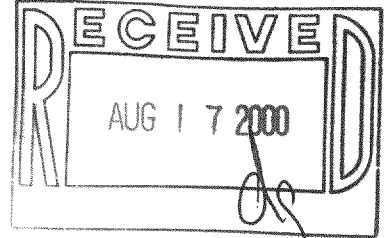

SCALE: 1" = 20'

LEGEND

- - FOUND IRON BAR
- - FOUND IRON PIPE
- () - RECORDED AS

HEREBY CERTIFY THAT I HAVE SURVEYED THE ABOVE DESCRIBED PROPERTY AND THE ABOVE MAP IS A TRUE REPRESENTATION THEREOF AND SHOWS THE SIZE AND LOCATION OF THE PROPERTY, THE LOCATION OF ALL VISIBLE STRUCTURES AND DIMENSIONS OF ALL PRINCIPAL BUILDINGS THEREON, BOUNDARY FENCES, APPARENT EASEMENTS, ROADWAY AND VISIBLE ENCROACHMENTS, IF ANY.

THIS SURVEY IS MADE FOR THE PRESENT OWNERS OF THE PROPERTY, AND ALSO THOSE WHO PURCHASE, OR GUARANTEE THE TITLE THERETO WITHIN (1) YEAR FROM THE DATE HEREOF

DATED AT WATERFORD, WI THIS 19th DAY OF JULY 2000

RECEIVED

Gregory B. Foat

118-1954

MPL-1394