
PLAT OF SURVEY

-OF-

LOTS 15 THROUGH 20, BLOCK 16, LAKE IVANHOE RESORT, ACCORDING TO THE RECORDED PLAT THEREOF. SAID LAND BEING IN THE TOWN OF BLOOMFIELD, COUNTY OF WALWORTH AND STATE OF WISCONSIN.


SURVEY FOR: SOUTHEASTERN WISCONSIN HOUSING CORPORATION



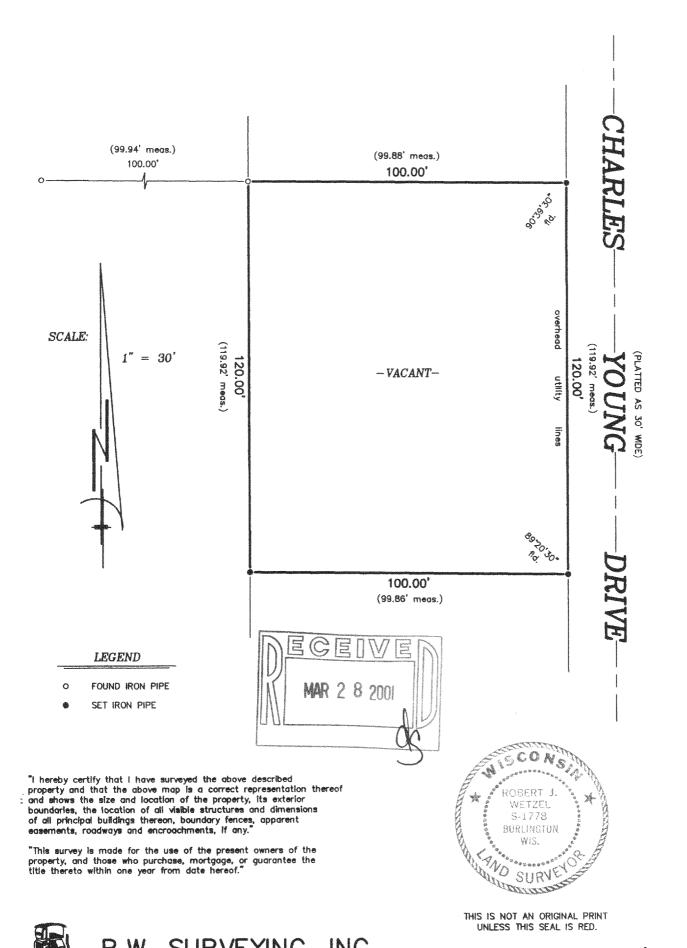

B.W. SURVEYING, INC.

412 N. PINE STREET BURLINGTON, WI 53105 (262)-767-0225

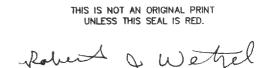

ROBERT J. WETZEL

MARCH 26, 2001 DATE

4831

JOB NUMBER

S-1778

118-2015