
PLAT OF SURVEY -OF-

LOTS 5629 TO 5633 BOTH INCLUSIVE, BLOCK 102, "MAP OF SECTION 3 OF PELL LAKE", LOCATED IN SECTION 15, TOWNSHIP 1 NORTH, RANGE 18 EAST, TOWN OF BLOOMFIELD, WALWORTH COUNTY, WISCONSIN.

SURVEY FOR: RE/MAX SOUTHERN LAKES SURVEY LOCATION: W1054 HYACINTH ROAD




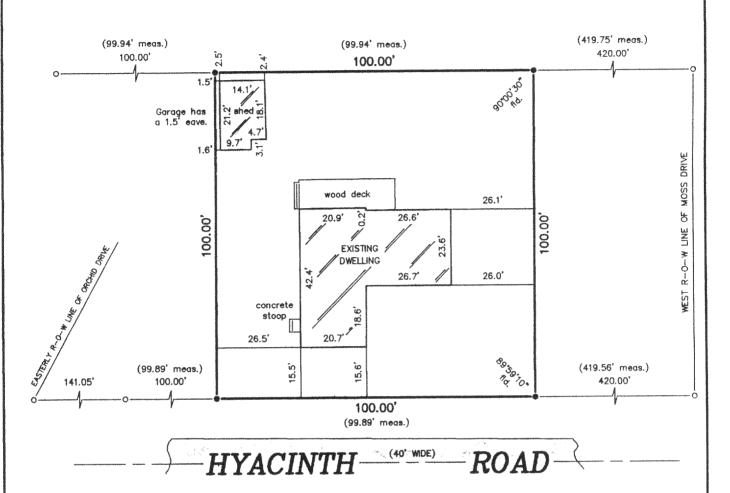

- O FOUND IRON PIPE
- SET IRON PIPE

"I hereby certify that I have surveyed the above described property and that the above map is a correct representation thereof and shows the size and location of the property, its exterior boundaries, the location of all visible structures and dimensions of all principal buildings thereon, boundary fences, apparent easements, roadways and encroachments, if any."

"This survey is made for the use of the present owners of the property, and those who purchase, mortgage, or guarantee the title thereto within one year from date hereof."

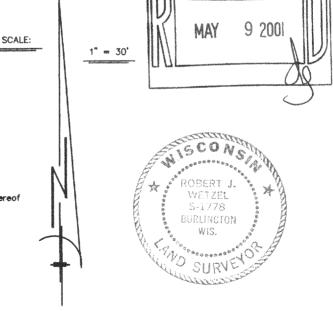

THIS IS NOT AN ORIGINAL PRINT UNLESS THIS SEAL IS RED.

eceiv



B.W. SURVEYING, INC.

412 N. PINE STREET BURLINGTON, WI 53105 (262)-767-0225 ROBERT J. WETZELS S-1778

MARCH 30, 2001 DATE 4880 JOB NUMBER

MPL-1221