

DEGEN, FOAT SURVEYING ASSOCIATES

100 SOUTH SECOND STREET

WATERFORD, WISCONSIN

(262)534-5404

(FAX)534-2022



PLAT OF SURVEY

LOTS 6035 THRU 6038, BLOCK 134, IN SECTION 4 OF PELL LAKE
SUBDIVISION, LOCATED IN TOWN 1 NORTH, RANGE 18 EAST, TOWN OF
OF BLOOMFIELD, WALWORTH COUNTY, WISCONSIN.

SURVEY PREPARED FOR:

COLDWELL BANKER, LAKE & COUNTRY
336 E. MAIN STREET, P.O. BOX 727
TWIN LAKES, WISCONSIN 53181

GOLDEN GLOW DRIVE
(40' WIDE)

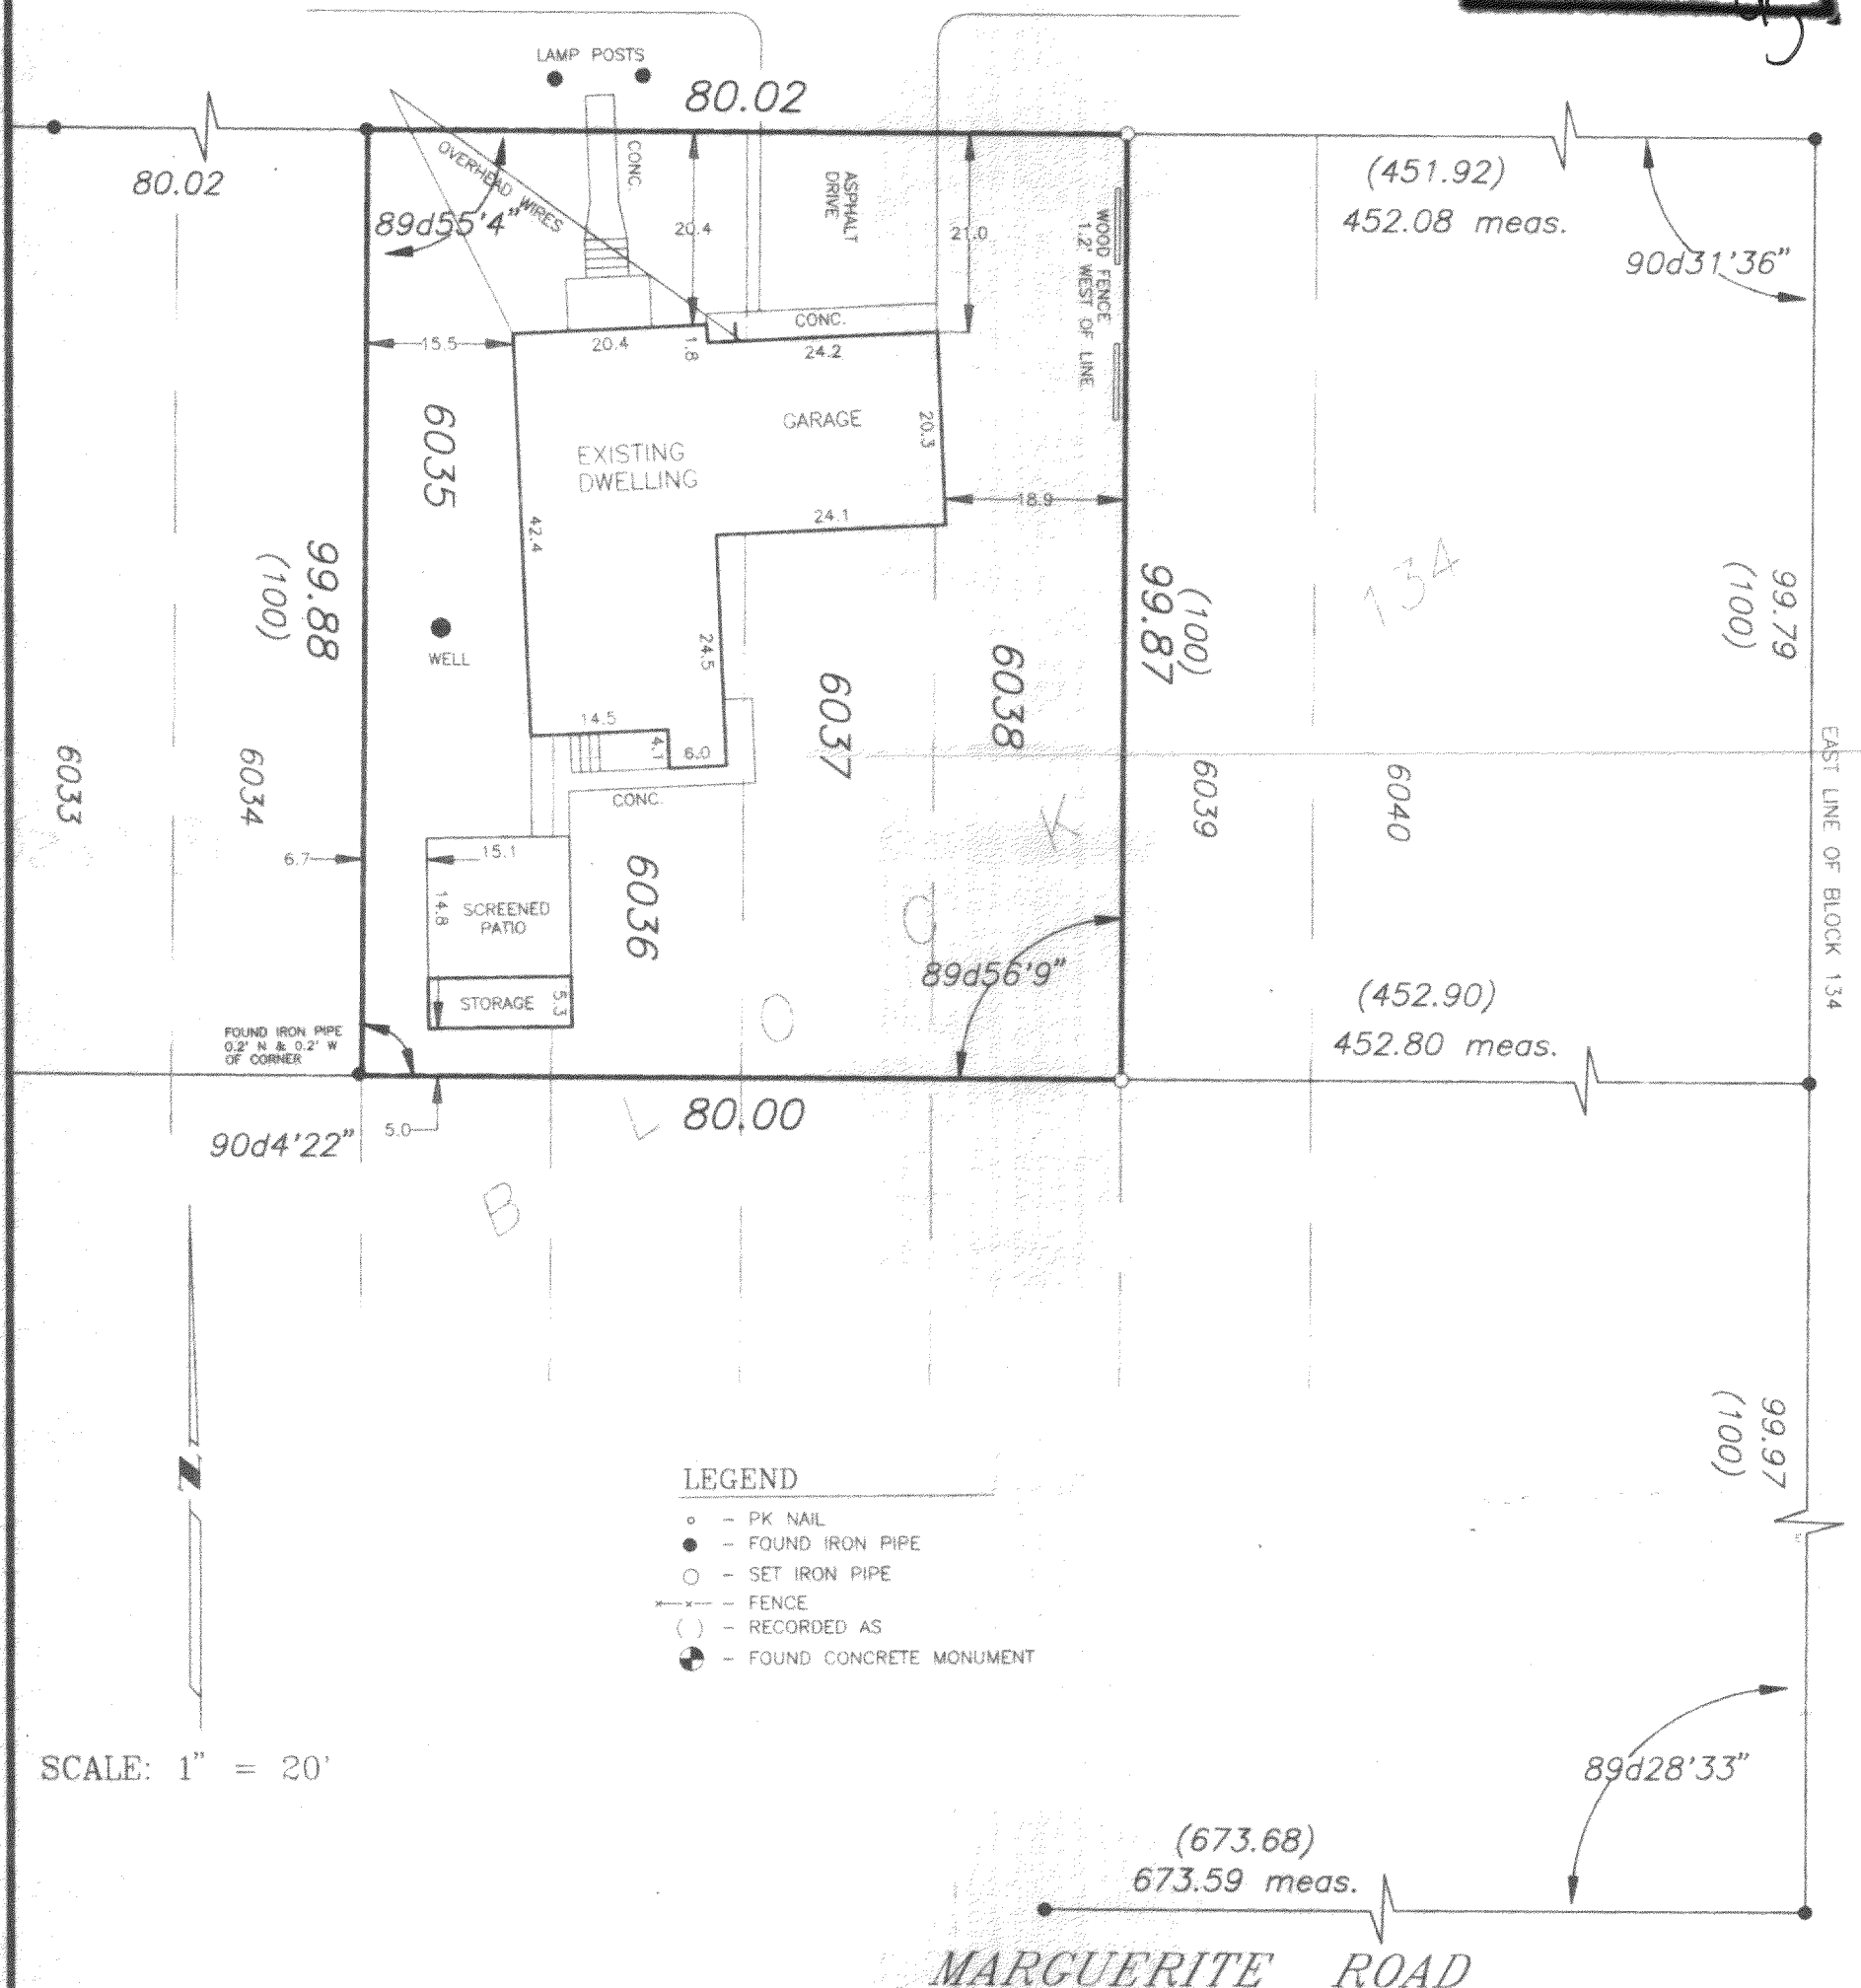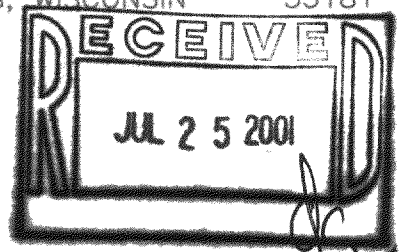

LEGEND

- - PK NAIL
- - FOUND IRON PIPE
- - SET IRON PIPE
- - FENCE
- () - RECORDED AS
- ⊙ - FOUND CONCRETE MONUMENT

SCALE: 1" = 20'

MARGUERITE ROAD

I HEREBY CERTIFY THAT I HAVE SURVEYED THE ABOVE DESCRIBED PROPERTY AND THE ABOVE MAP IS A TRUE REPRESENTATION THEREOF AND SHOWS THE SIZE AND LOCATION OF THE PROPERTY, THE LOCATION OF ALL VISIBLE STRUCTURES AND DIMENSIONS OF ALL PRINCIPAL BUILDINGS THEREON, BOUNDARY FENCES, APPARENT EASEMENTS, ROADWAY AND VISIBLE ENCROACHMENTS, IF ANY.

THIS SURVEY IS MADE FOR THE PRESENT OWNERS OF THE PROPERTY, AND ALSO THOSE WHO PURCHASE, OR GUARANTEE THE TITLE THERETO WITHIN (1) YEAR FROM THE DATE HEREOF.

DATED AT WATERFORD, WI THIS 14th DAY OF DECEMBER 2000

RECERTIFIED:

James E. Stubbs