


DUNHAM SURVEYING, S.C.
SURVEYING & SUBDIVIDING
DELAVER, WISCONSIN 53115

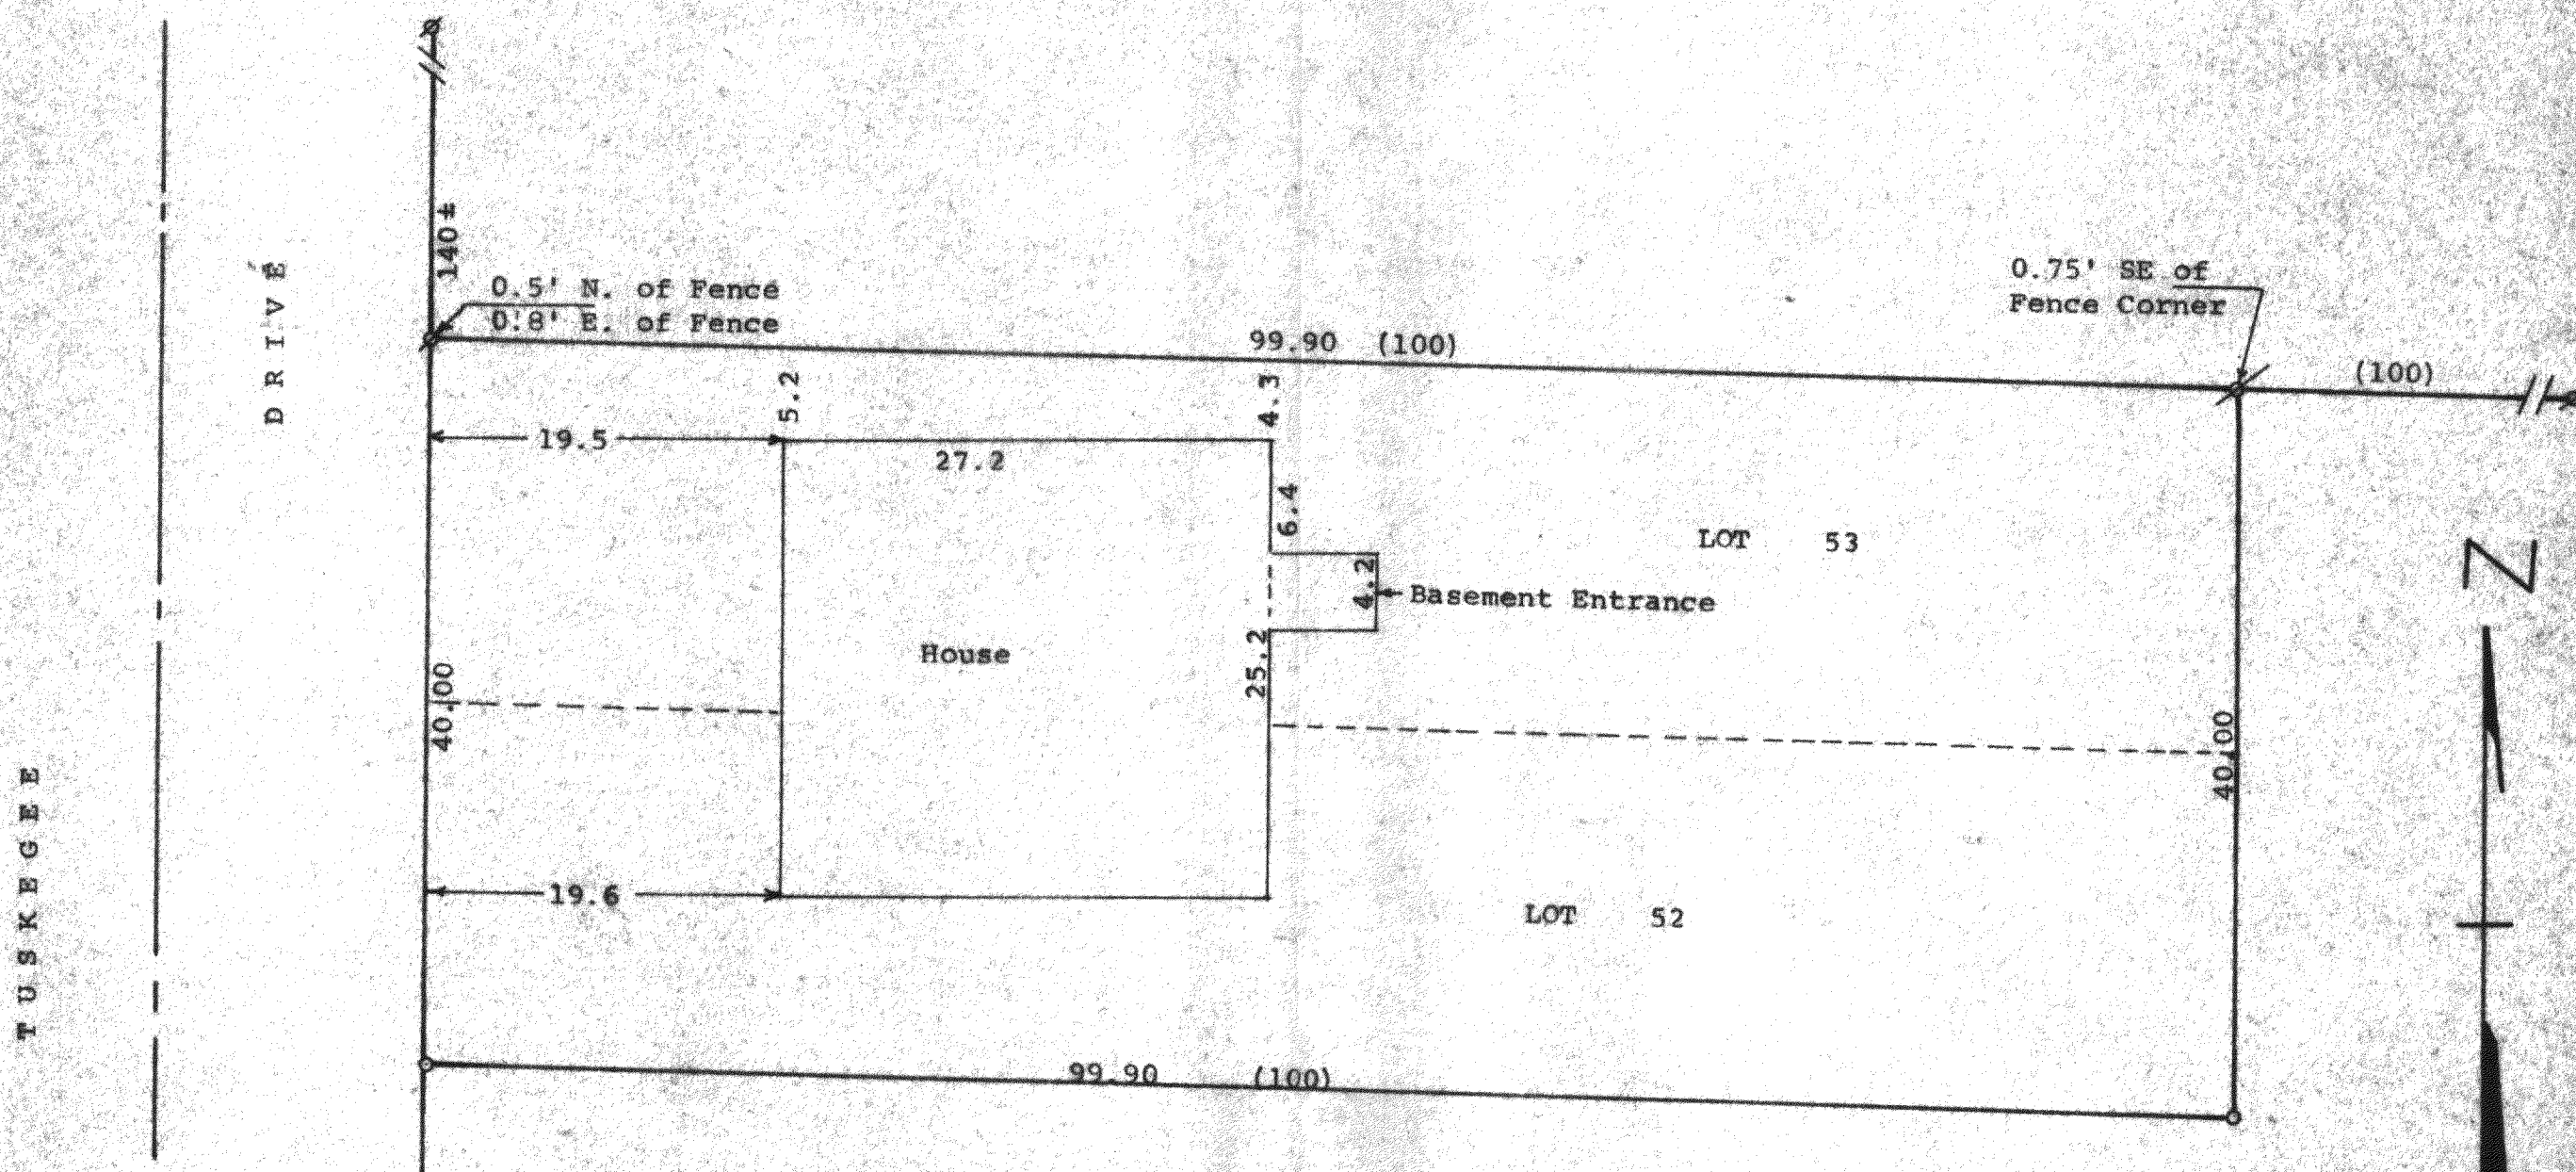

Scale - 1" = 10'
 Ø = 1" Iron Pipe Found
 o = 1/2" Iron Pipe Set
 (0.00) = Recorded Distance
 Survey ordered by:
 Valerie Lyon
 986 S. Lake Shore Drive
 Fontana, WI 53125

STATE OF WISCONSIN)
 COUNTY OF WALWORTH) SS

I, George T. Dunham, Surveyor, certify that I have surveyed the property described as follows:

Lots 52 and 53 in Block 4, of Lake Ivanhoe Resort, a subdivision located in the Town of Bloomfield, Walworth County, Wisconsin, and that the plat shown hereon is a correct representation thereof and shows the size and location of the property, its exterior boundaries, the location of all visible structures and dimensions of all principal buildings thereon, boundary fences, apparent easements, roadways and visible encroachments, if any, and that I have surveyed the property hereon described, according to the official records, to the best of my knowledge and belief.
 August 27, 1999

George T. Dunham
 George T. Dunham, Surveyor

