


HAROLD H. KOLB

REGISTERED PROFESSIONAL LAND SURVEYOR
LAKE GENEVA, WISCONSIN

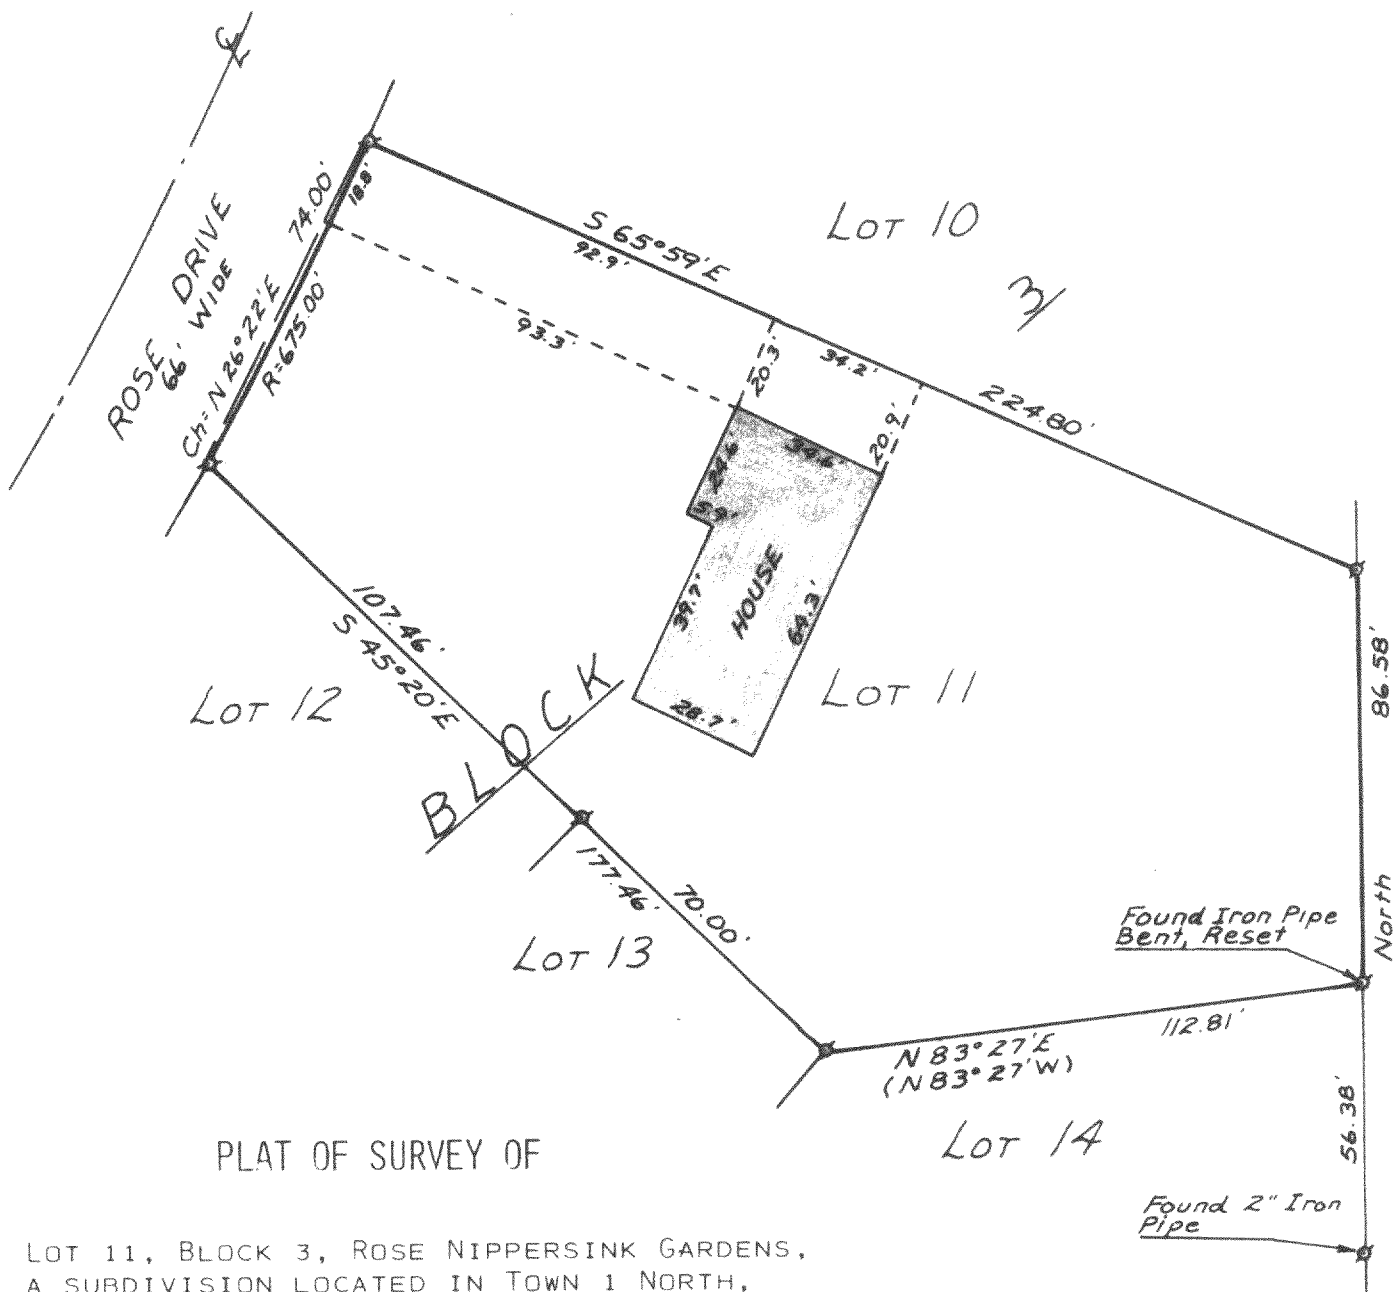


PLAT OF SURVEY OF

LOT 11, BLOCK 3, ROSE NIPPERSINK GARDENS,
A SUBDIVISION LOCATED IN TOWN 1 NORTH,
RANGE 18 EAST, WALWORTH COUNTY, WISCONSIN.

NOTE: BEARINGS TAKEN FROM ORIGINAL
PLAT OF ROSE NIPPERSINK
GARDENS SUBDIVISION.

ORDERED BY: RONALD EHRLICH
ROUTE 1--BOX N-74
GENOA CITY, WI 53128

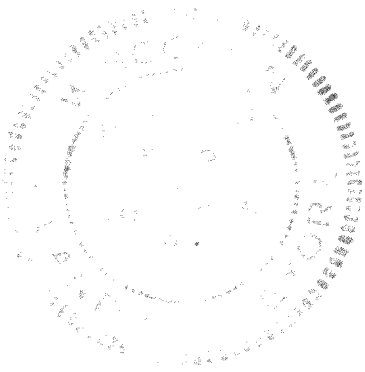

SCALE: 1"=40'

LEGEND

- O — IRON PIPE PLACED, 1" x 24" 1.13 LB./LIN. FT.
- — CONCRETE MONUMENT, 5" DIA. x 30"
- () — AS PLATTED
- Ø — FOUND IRON PIPE

I, HAROLD H. KOLB, DO HEREBY CERTIFY THAT I HAVE
SURVEYED THE PROPERTY HEREON DESCRIBED ACCORDING
TO THE OFFICIAL RECORDS, AND THAT THE PLAT HEREON
IS A CORRECT REPRESENTATION OF THE LOT LINES.

Harold H. Kolb
HAROLD H. KOLB
WISCONSIN REGISTERED LAND SURVEYOR, S-187
DATE Sept. 6, 1978