
PLAT OF SURVEY

PHONE 262-537-4874 FAX

262-537-4221

OF

Lots 6564 thru 6567, Block 143 of SECTION 4 PELL LAKE SUBDIVISION, being a subdivision of part of Section 15, Township 1 North, Range 18 East of the 4th Principal Meridian, Bloomfield Township, Walworth County, Wisconsin.

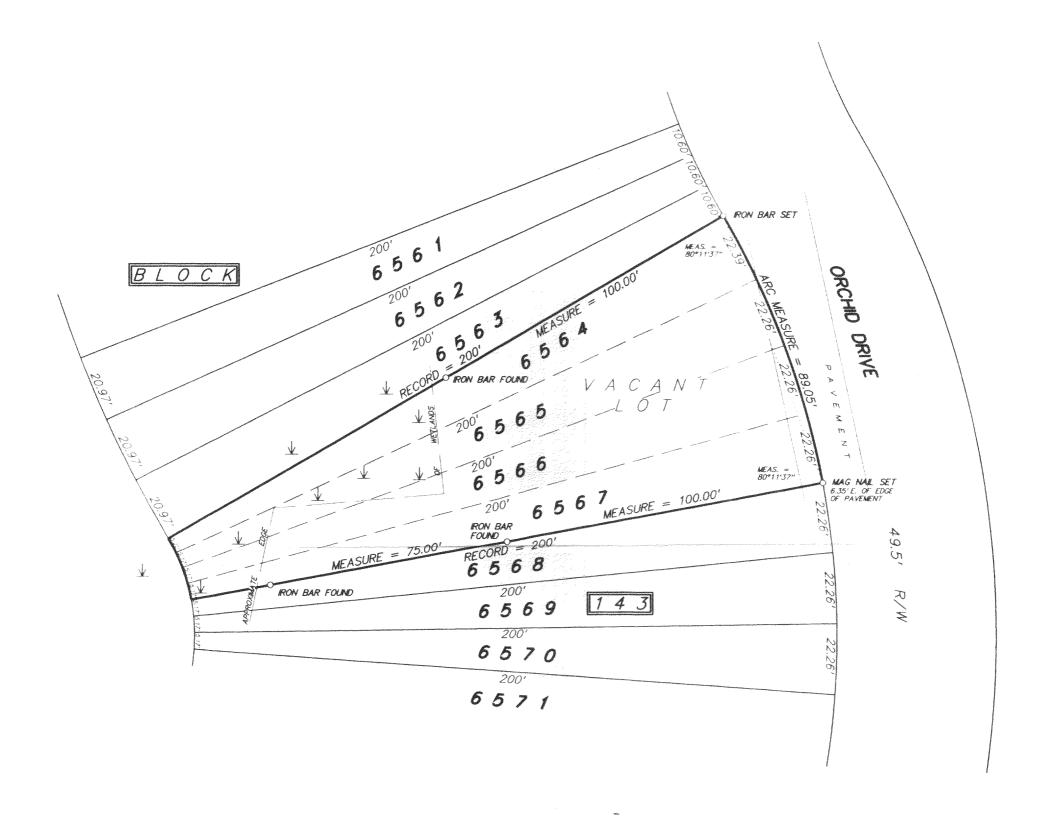

M	SCALE	1 inch = 30 feet
A 4		
	ORDERED BY_	E. Gorzelonczwk
Å	JOB NO	03073
	DECEIVED JUN - 5 2003	

I hereby certify that I have surveyed the above described property and the above plat is a true representation thereof and shows the size and location of the property, its exterior boundaries, the location and dimensions of all visible structures thereon, boundary fences, apparent easements and roadways and visible encroachments, if any.

This survey is made for the exclusive use of the present owners of the property, and also those who purchase, mortgage, or guarantee the title thereto within one year from the date hereof.

Dated at Bassett, Wisconsin this <u>14th</u> day of <u>April</u>

Mark A. Bolender Wisconsin Registered Land Surveyor S - 1784