


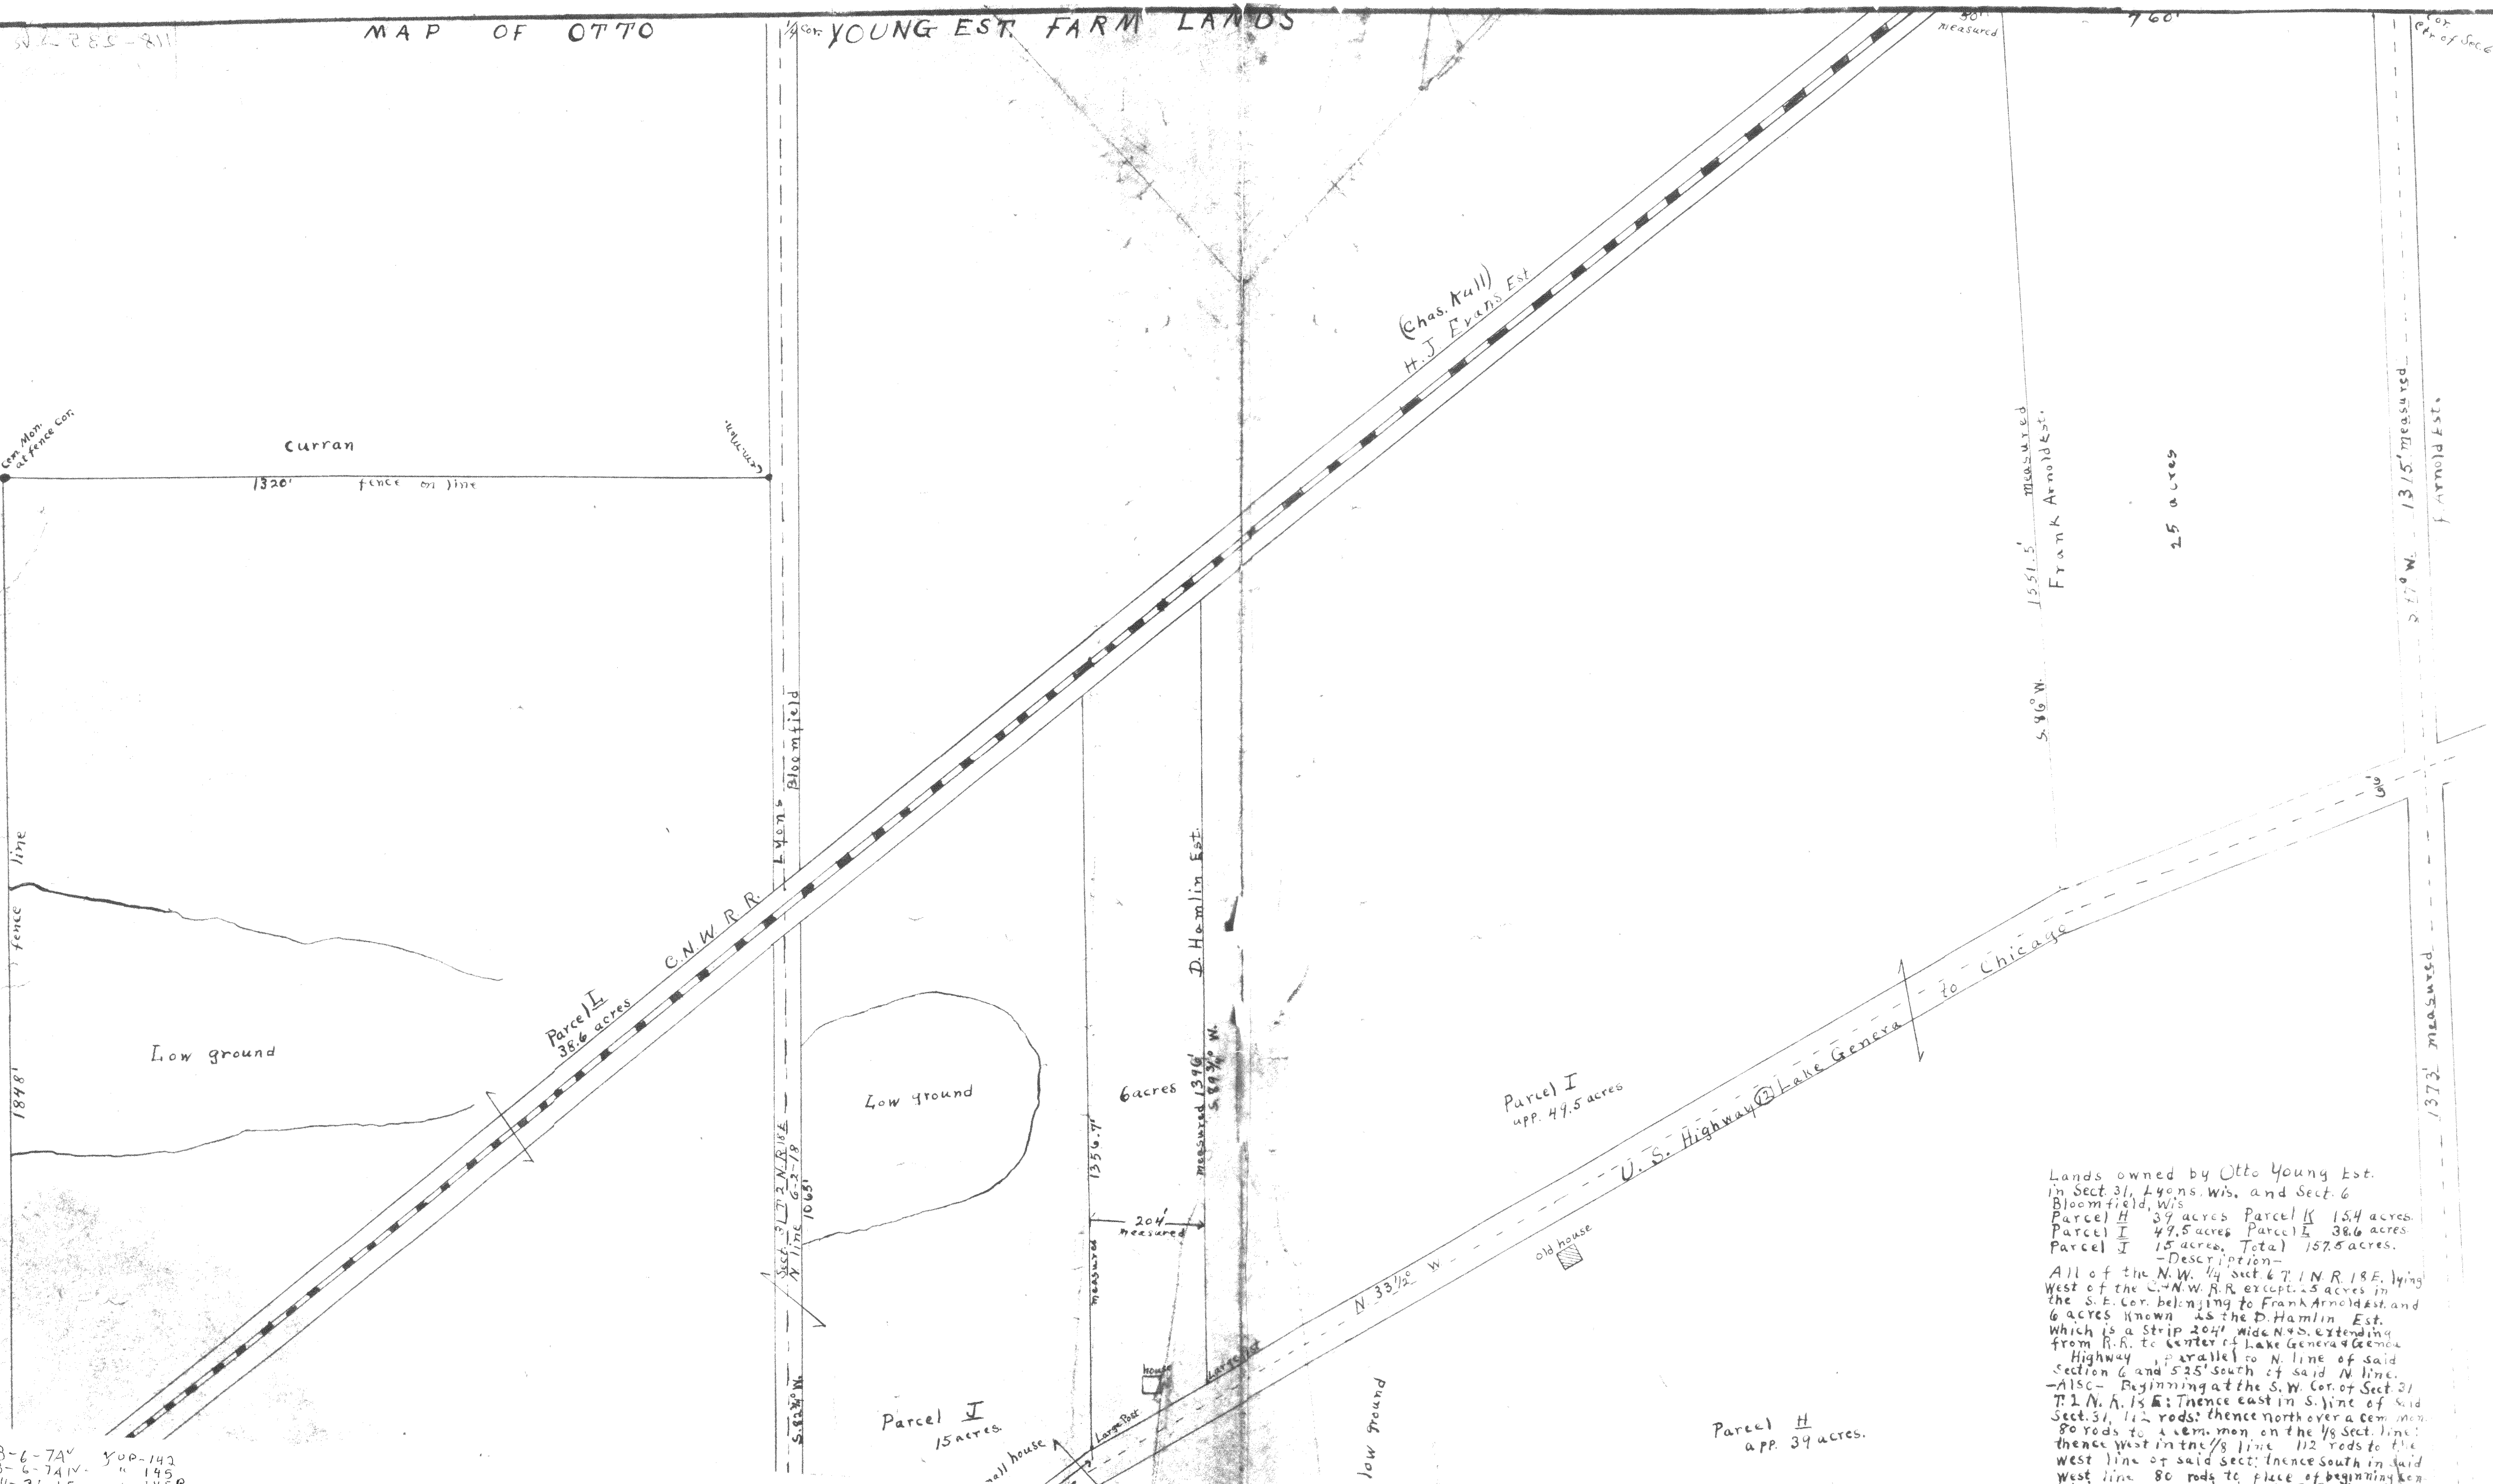

6-5 B-6-7A^v YOP-143
6-6+ 8-6-7A^v " 145
6-11A 4-31-15 " 145B
" 145D+E C.S. 1118
" 149E & F " 812

Lands owned by Otto Young Est.
in Sect. 31, Lyons, Wis. and Sect. 6
Bloomfield, Wis.
Parcel H 39 acres Parcel K 15.4 acres
Parcel I 49.5 acres Parcel L 38.6 acres
Parcel J 15 acres Total 157.5 acres.
-Description-
All of the N.W. 1/4 Sect. 6 T. 2 N. R. 18 E. lying
west of the C. & N.W. R.R. except 2.5 acres in
the S.E. Cor. belonging to Frank Arnold Est. and
6 acres known as the D. Hamlin Est.
which is a strip 204' wide N. & S. extending
from R.R. to center of Lake Geneva & Geneva
Highway, parallel to N. line of said
Section 6 and 525' south of said N. line.
-Also- Beginning at the S.W. Cor. of Sect. 31
T. 2 N. R. 18 E. Thence east in S. line of said
Sect. 31 112 rods; thence north over a cem. mon.
80 rods to a cem. mon. on the 1/8 Sect. line;
thence west in the 1/8 line 112 rods to the
west line of said Sect.; thence south in said
west line 80 rods to place of beginning ken
taining 54 acres exclusive of R.R. A cem. mon.
marks N. line at R.R. line
Sept. 4, 1920.
J. G. Skeels, Surveyor
Bessie M. Palmer, Asst.

118-235 sk