

DEGEN-FOAT SURVEYING LLC
100 SOUTH SECOND STREET
WATERFORD, WISCONSIN
(262)534-5404 (FAX)534-2022

037050
037050S1.DWG

PLAT OF SURVEY

LOT 6 OF GRA DEN WOODS, A RECORDED SUBDIVISION LOCATED IN THE
NORTH 1/2 OF THE SOUTHEAST 1/4 OF SECTION 26, TOWN 1 NORTH, RANGE 18 EAST,
TOWN OF BLOOMFIELD, WALWORTH COUNTY, WISCONSIN

• REFER TO CURRENT TITLE REPORT FOR EASEMENTS, RESTRICTIONS OR COVENANTS OF RECORD THAT MAY AFFECT THIS LAND •
• ESPECIALLY THOSE NOT SHOWN ON THE RECORDED PLAT OF GRA DEN WOODS SUBDIVISION •


SURVEY PREPARED FOR:
R.J. MOEN CONSTRUCTION
W 1040 SUNDEW ROAD
GENOA CITY, WISCONSIN 53128



SCALE: 1" = 40'

LEGEND

- ⊙ - FOUND IRON PIPE
- - FOUND IRON ROD
- - SET IRON PIPE
- FENCE
- () - RECORDED AS

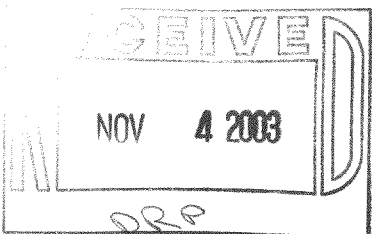

I HEREBY CERTIFY THAT I HAVE SURVEYED THE ABOVE DESCRIBED PROPERTY AND THE ABOVE MAP IS A TRUE REPRESENTATION THEREOF AND SHOWS THE SIZE AND LOCATION OF THE PROPERTY, THE LOCATION OF ALL VISIBLE STRUCTURES AND DIMENSIONS OF ALL PRINCIPAL BUILDINGS THEREON, BOUNDARY FENCES, APPARENT EASEMENTS, ROADWAY AND VISIBLE ENCROACHMENTS, IF ANY.

THIS SURVEY IS MADE FOR THE PRESENT OWNERS OF THE PROPERTY, AND ALSO THOSE WHO PURCHASE, OR GUARANTEE THE TITLE THERETO WITHIN (1) YEAR FROM THE DATE HEREOF.

DATED AT WATERFORD THIS 25TH DAY OF FEBRUARY 20 03

RECERTIFIED MAY 20, 2003

Gary B. Foat

MGDW-6

118-2361