


# ABELL SURVEYING & MAPPING

1140 SEQUOIA STREET • DELAVAN, WISCONSIN 53115  
262-728-6737

EAST FOREST ROAD

CHERRY DRIVE

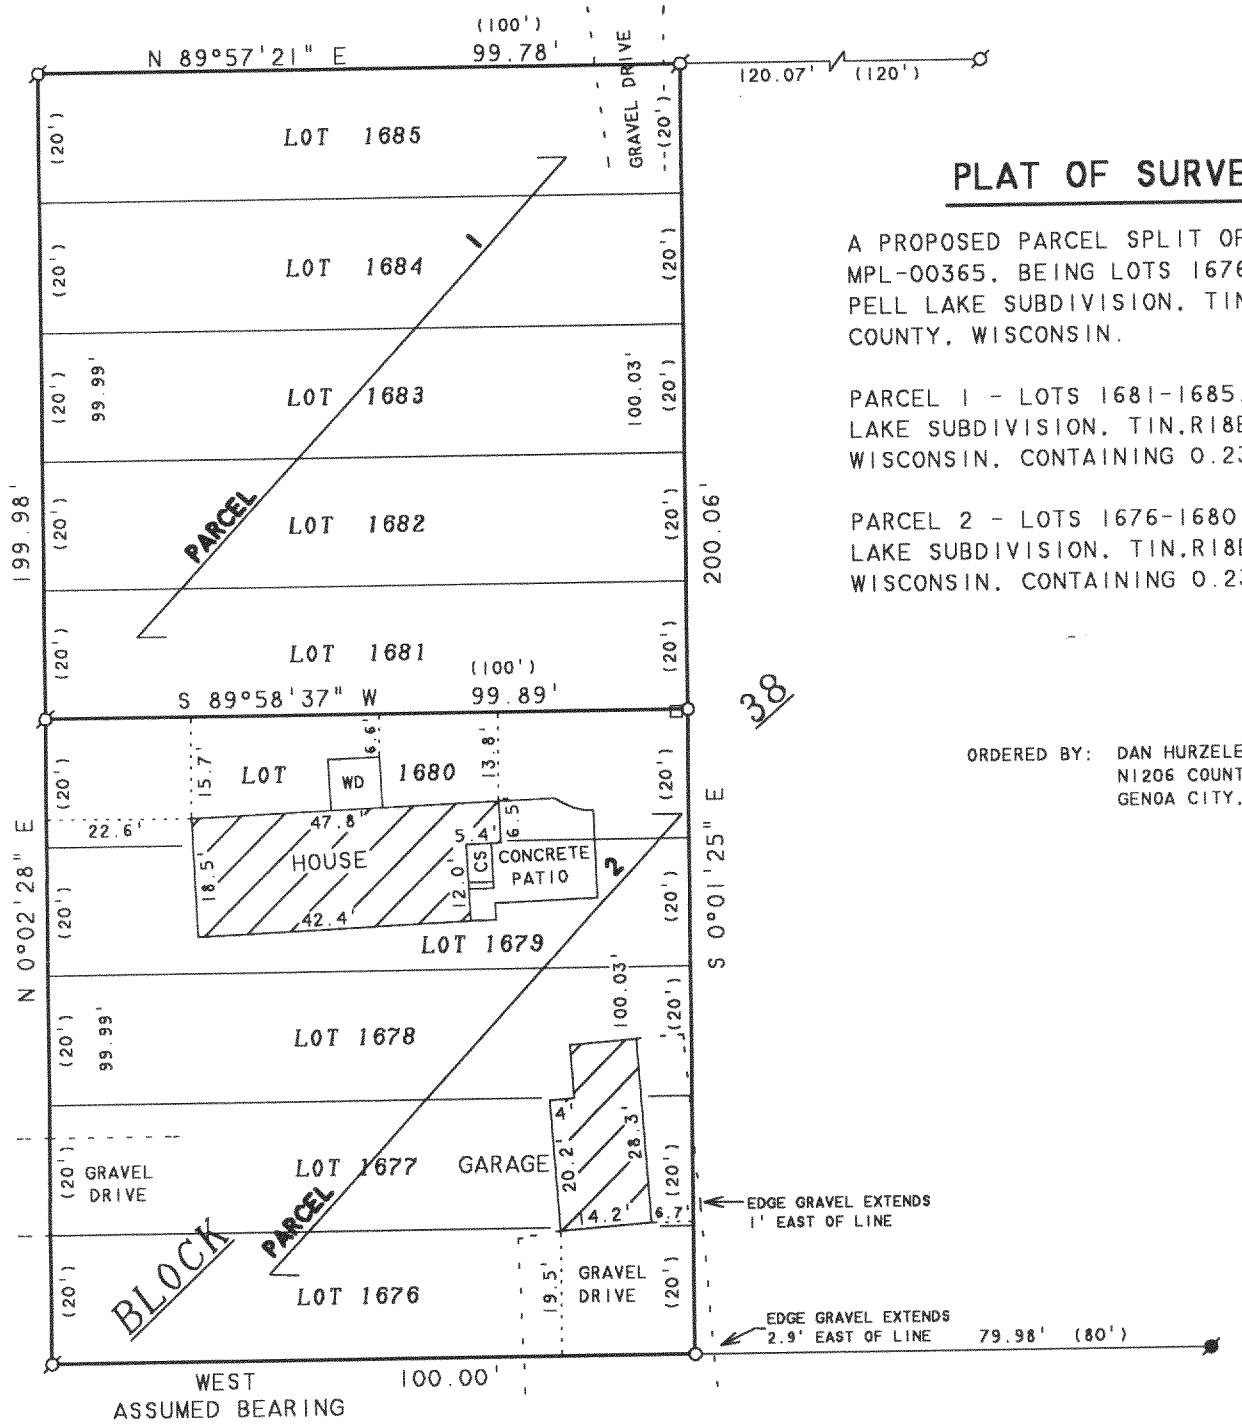


## PLAT OF SURVEY OF

A PROPOSED PARCEL SPLIT OF TAX PARCEL MPL-00365, BEING LOTS 1676-1685, BLOCK 38, PELL LAKE SUBDIVISION, T1N, R18E, WALWORTH COUNTY, WISCONSIN.

PARCEL 1 - LOTS 1681-1685, BLOCK 38, PELL LAKE SUBDIVISION, T1N, R18E, WALWORTH COUNTY, WISCONSIN, CONTAINING 0.23 ACRES.

PARCEL 2 - LOTS 1676-1680, BLOCK 38, PELL LAKE SUBDIVISION, T1N, R18E, WALWORTH COUNTY, WISCONSIN, CONTAINING 0.23 ACRES.

ORDERED BY: DAN HURZELE  
N1206 COUNTY HIGHWAY "H"  
GENOA CITY, WI 53128

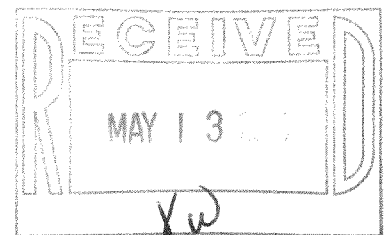

N



SCALE 1"=30'

### LEGEND

- - IRON PIPE FOUND
- - IRON ROD FOUND
- - 1" DIA. IRON PIPE SET
- CS - CONCRETE STOOP
- - UTILITY PED.
- WD - WOOD DECK
- ( ) - RECORDED AS

I HEREBY CERTIFY THAT I HAVE SURVEYED THE ABOVE DESCRIBED PROPERTY AND THAT THE ABOVE MAP IS A TRUE REPRESENTATION THEREOF AND SHOWS THE SIZE AND LOCATION OF THE PROPERTY, ITS EXTERIOR BOUNDARIES, THE LOCATION OF ALL VISIBLE STRUCTURES AND DIMENSIONS OF ALL PRINCIPAL BUILDINGS THEREON, BOUNDARY FENCES, APPARENT EASEMENTS, ROADWAYS AND VISIBLE ENCROACHMENTS, IF ANY, TO THE BEST OF MY KNOWLEDGE AND BELIEF.

THIS SURVEY IS MADE FOR THE USE OF THE PRESENT OWNERS OF THE PROPERTY, AND ALSO THOSE WHO PURCHASE, MORTGAGE, OR GUARANTEE THE TITLE THERETO WITHIN ONE (1) YEAR FROM DATE HEREON.

*David F. Abell*

DAVID F. ABELL  
WISCONSIN REGISTERED LAND SURVEYOR, S-1596

February 18, 2004

DATE JOB NUMBER - 02011  
NOTE: THIS IS NOT A CERTIFIED COPY UNLESS SEALED.

MPL 00365  
MPL 00366

118-2429