


PREPARED FOR:
LOLITA BACON

J.K. SURVEYING INC.
N3705 WILLOWBEND LANE
LAKE GENEVA, WI 53147
(262) 248-3697

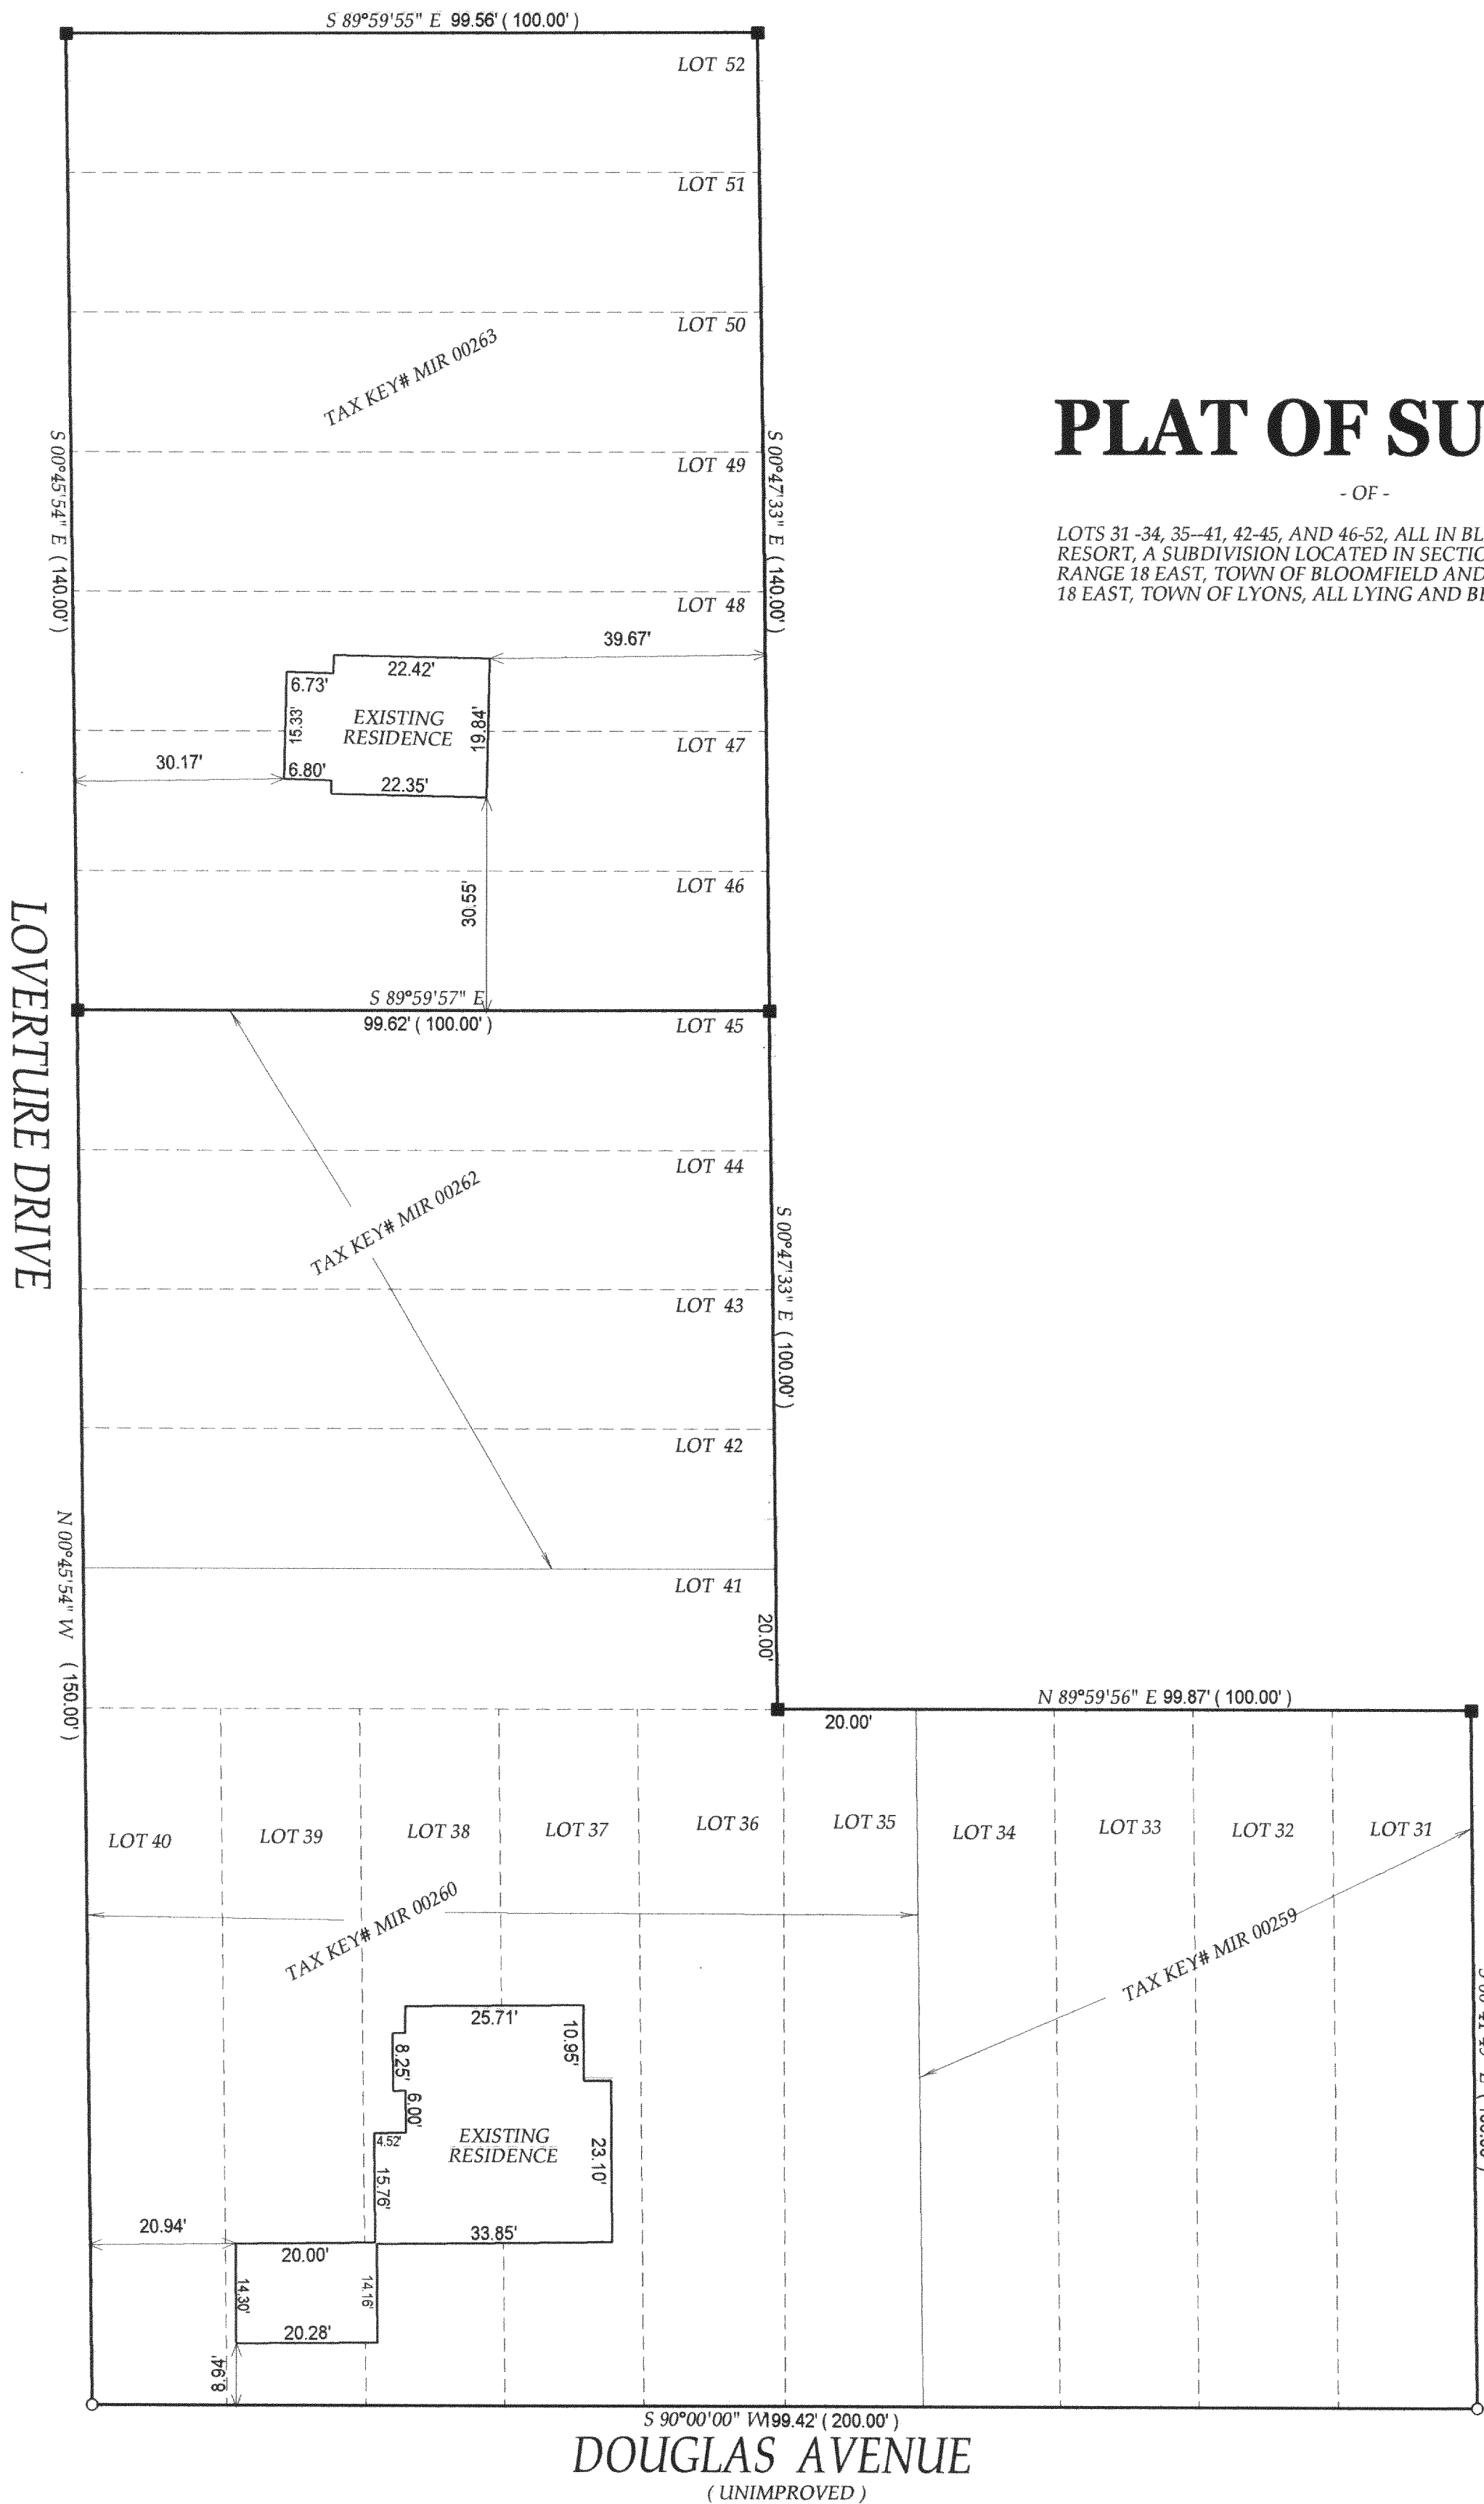

PLAT OF SURVEY

- OF -

LOTS 31-34, 35-41, 42-45, AND 46-52, ALL IN BLOCK 15 OF LAKE IVANHOE RESORT, A SUBDIVISION LOCATED IN SECTIONS 2 AND 3, TOWN 1 NORTH, RANGE 18 EAST, TOWN OF BLOOMFIELD AND IN SECTION 34, TOWN 2 NORTH, RANGE 18 EAST, TOWN OF LYONS, ALL LYING AND BEING IN WALWORTH COUNTY, WISCONSIN.

- () = RECORDED AS
- = FOUND IRON BAR
- = FOUND IRON PIPE
- = SET IRON PIPE
- = SET IRON BAR

SCALE: 1" = 20'


JOB #: 04-379

TAX ID #: SEE PARCELS

MIR-259
MIR-260
MIR-262
MIR-263

COMPARE LEGAL DESCRIPTION ABOVE AND DRAWING WITH DEED, FOR BUILDING RESTRICTIONS AND EASEMENTS NOT SHOWN, REFER TO DEED, ABSTRACT SOURCES AND LOCAL MUNICIPAL CODES. NOTIFY THE SURVEYOR IMMEDIATELY OF ANY DISCREPANCY.

"I hereby certify that I have surveyed the above described property and that the above map, to the best of my knowledge and belief, is a true representation thereof and shows the size and location of all visible structures, apparent easements and encroachments if any."
This survey is made for the present owners of the property, and those who purchase, mortgage, or guarantee the title thereto, within one year from the date hereof.

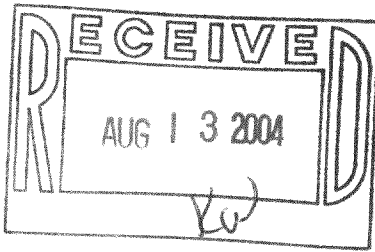

JEFFREY L. KIMPS S-2436
Wisconsin Registered Land Surveyor
(original if signed in red)

DATED THIS 3rd DAY OF AUGUST, 2004

118-2453