


PLAT OF SURVEY
-OF-

LOTS 22, 23, 24, 25, 26, 27, 28, 29 AND 30, BLOCK 2, LAKE IVANHOE RESORT SUBDIVISION,
ACCORDING TO THE RECORDED PLAT THEREOF. SAID LAND BEING IN THE TOWN OF BLOOMFIELD,
COUNTY OF WALWORTH AND STATE OF WISCONSIN.


SURVEY FOR: SOUTHEASTERN WISCONSIN HOUSING CORPORATION

SURVEY LOCATION: _____ HOWARD DRIVE

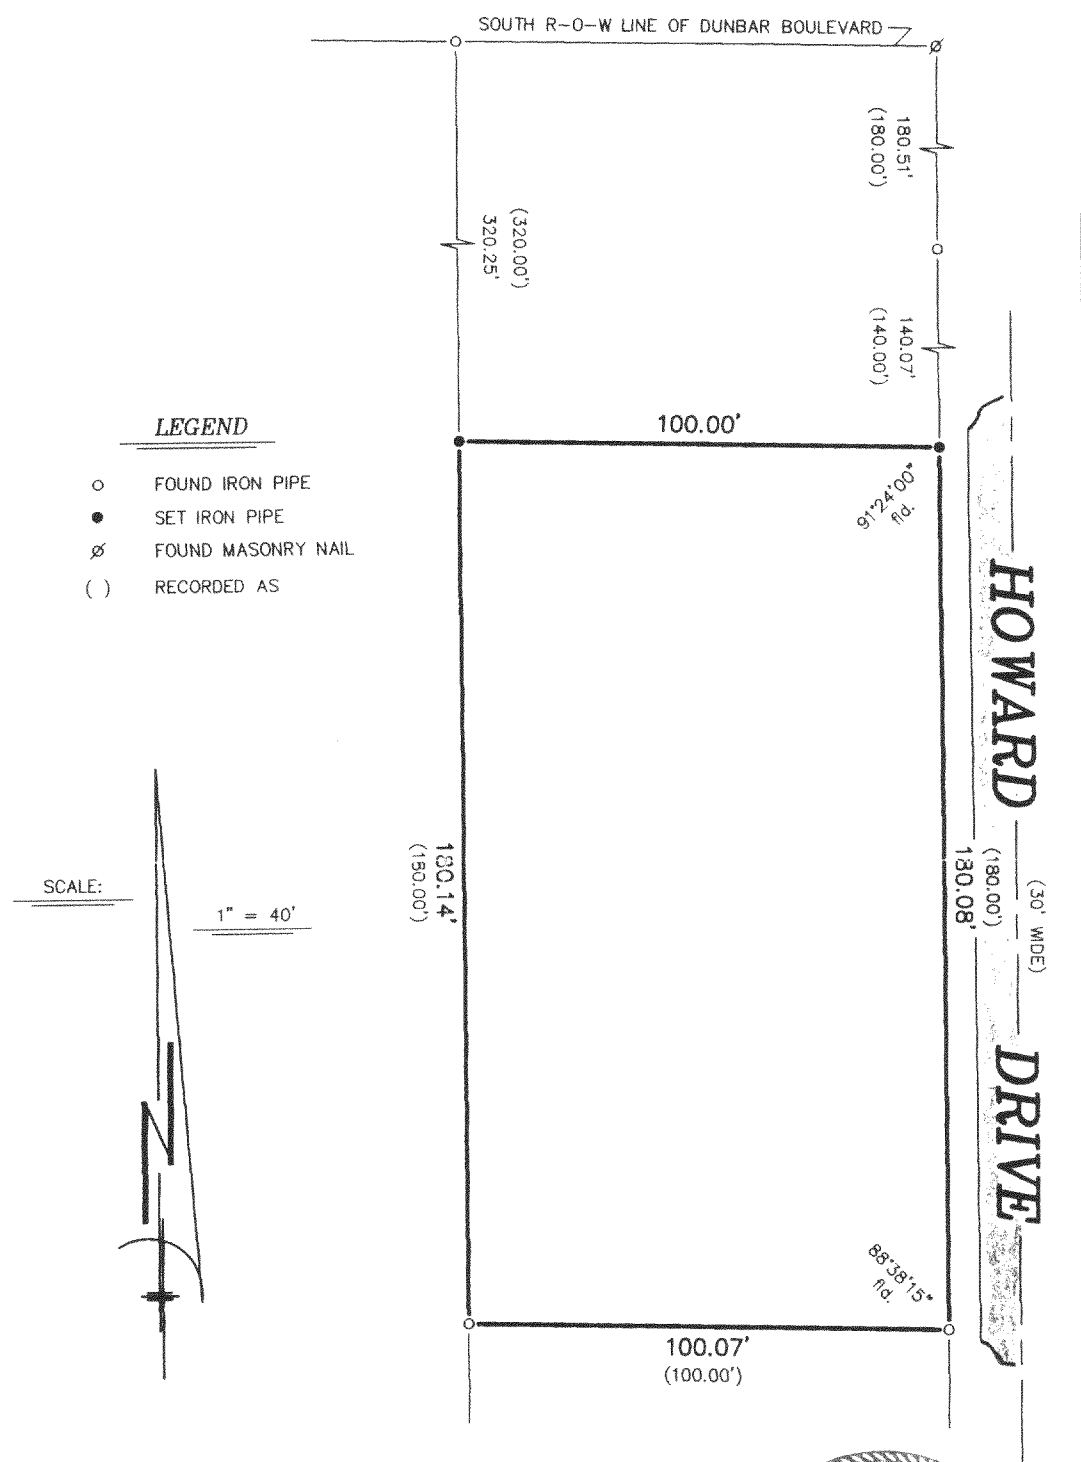


"I hereby certify that I have surveyed the above described property and that the above map is a correct representation thereof and shows the size and location of the property, its exterior boundaries, the location of all visible structures and dimensions of all principal buildings thereon, boundary fences, apparent easements, roadways and encroachments, if any."

"This survey is made for the use of the present owners of the property, and those who purchase, mortgage, or guarantee the title thereto within one year from date hereof."

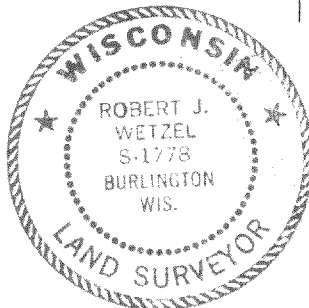

THIS IS NOT AN ORIGINAL PRINT
UNLESS THIS SEAL IS RED.

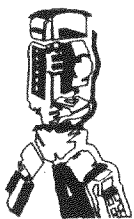

B.W. SURVEYING, INC.

412 N. PINE STREET
BURLINGTON, WI 53105
(262)-767-0225

Robert J. Wetzel
ROBERT J. WETZEL S-1778

FEBRUARY 24, 2005
DATE

6723
JOB NUMBER

MIR 00025

118-2631