
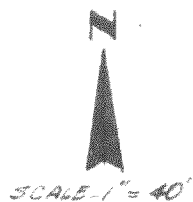



HAROLD H. KOLB

REGISTERED PROFESSIONAL LAND SURVEYOR
LAKE GENEVA, WISCONSIN

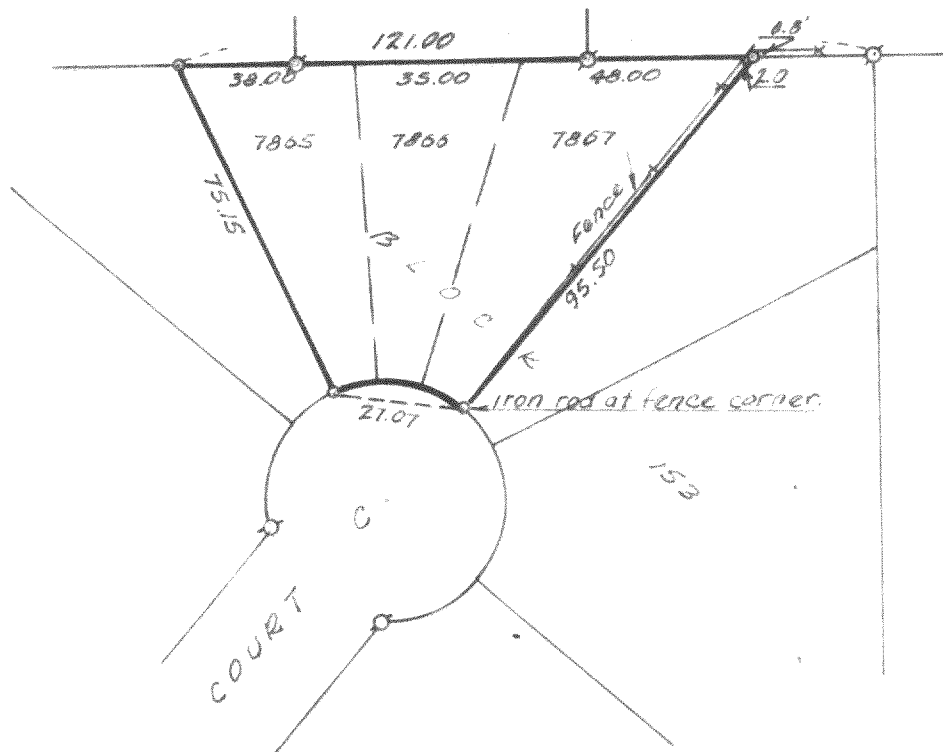

LEGEND

- Ø — IRON PIPE FOUND
- — IRON ROD PLACED
- — CONCRETE MONUMENT
- x — SPIKE

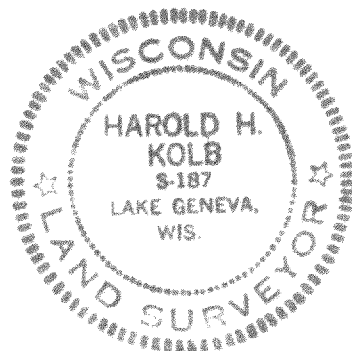

PLAT OF SURVEY OF
Lots 7865 thru 7867, Block 153, Sec.
5 of Pell Lake Subd., T 1 N, R 18 E,
Walworth County, Wisconsin

I, HAROLD H. KOLB, DO HEREBY CERTIFY THAT I HAVE
SURVEYED THE PROPERTY HEREON DESCRIBED ACCORDING
TO THE OFFICIAL RECORDS, AND THAT THE PLAT HEREON
IS A CORRECT REPRESENTATION OF THE LOT LINES.

Harold H. Kolb

HAROLD H. KOLB

WISCONSIN REGISTERED LAND SURVEYOR, S-187

DATE APR. 24, 1969

118-265