


PLAT OF SURVEY

FAX 262-537-4221

PARCEL 11: The south 80 feet of Lots 1484 through 1489 excepting the east 13 feet of the south 80 feet of said Lot 1484, Block 32, PELL LAKE SUBDIVISION, Section 1 according to the recorded plat thereof. Said lands being in the Town of Bloomfield, Walworth County, Wisconsin

Legal description as provided. This legal description omits the north 20 feet of the east 13 feet of Lot 1484, Block 32. This omitted parcel is occupied by PARCEL 1. 1 4 4 6

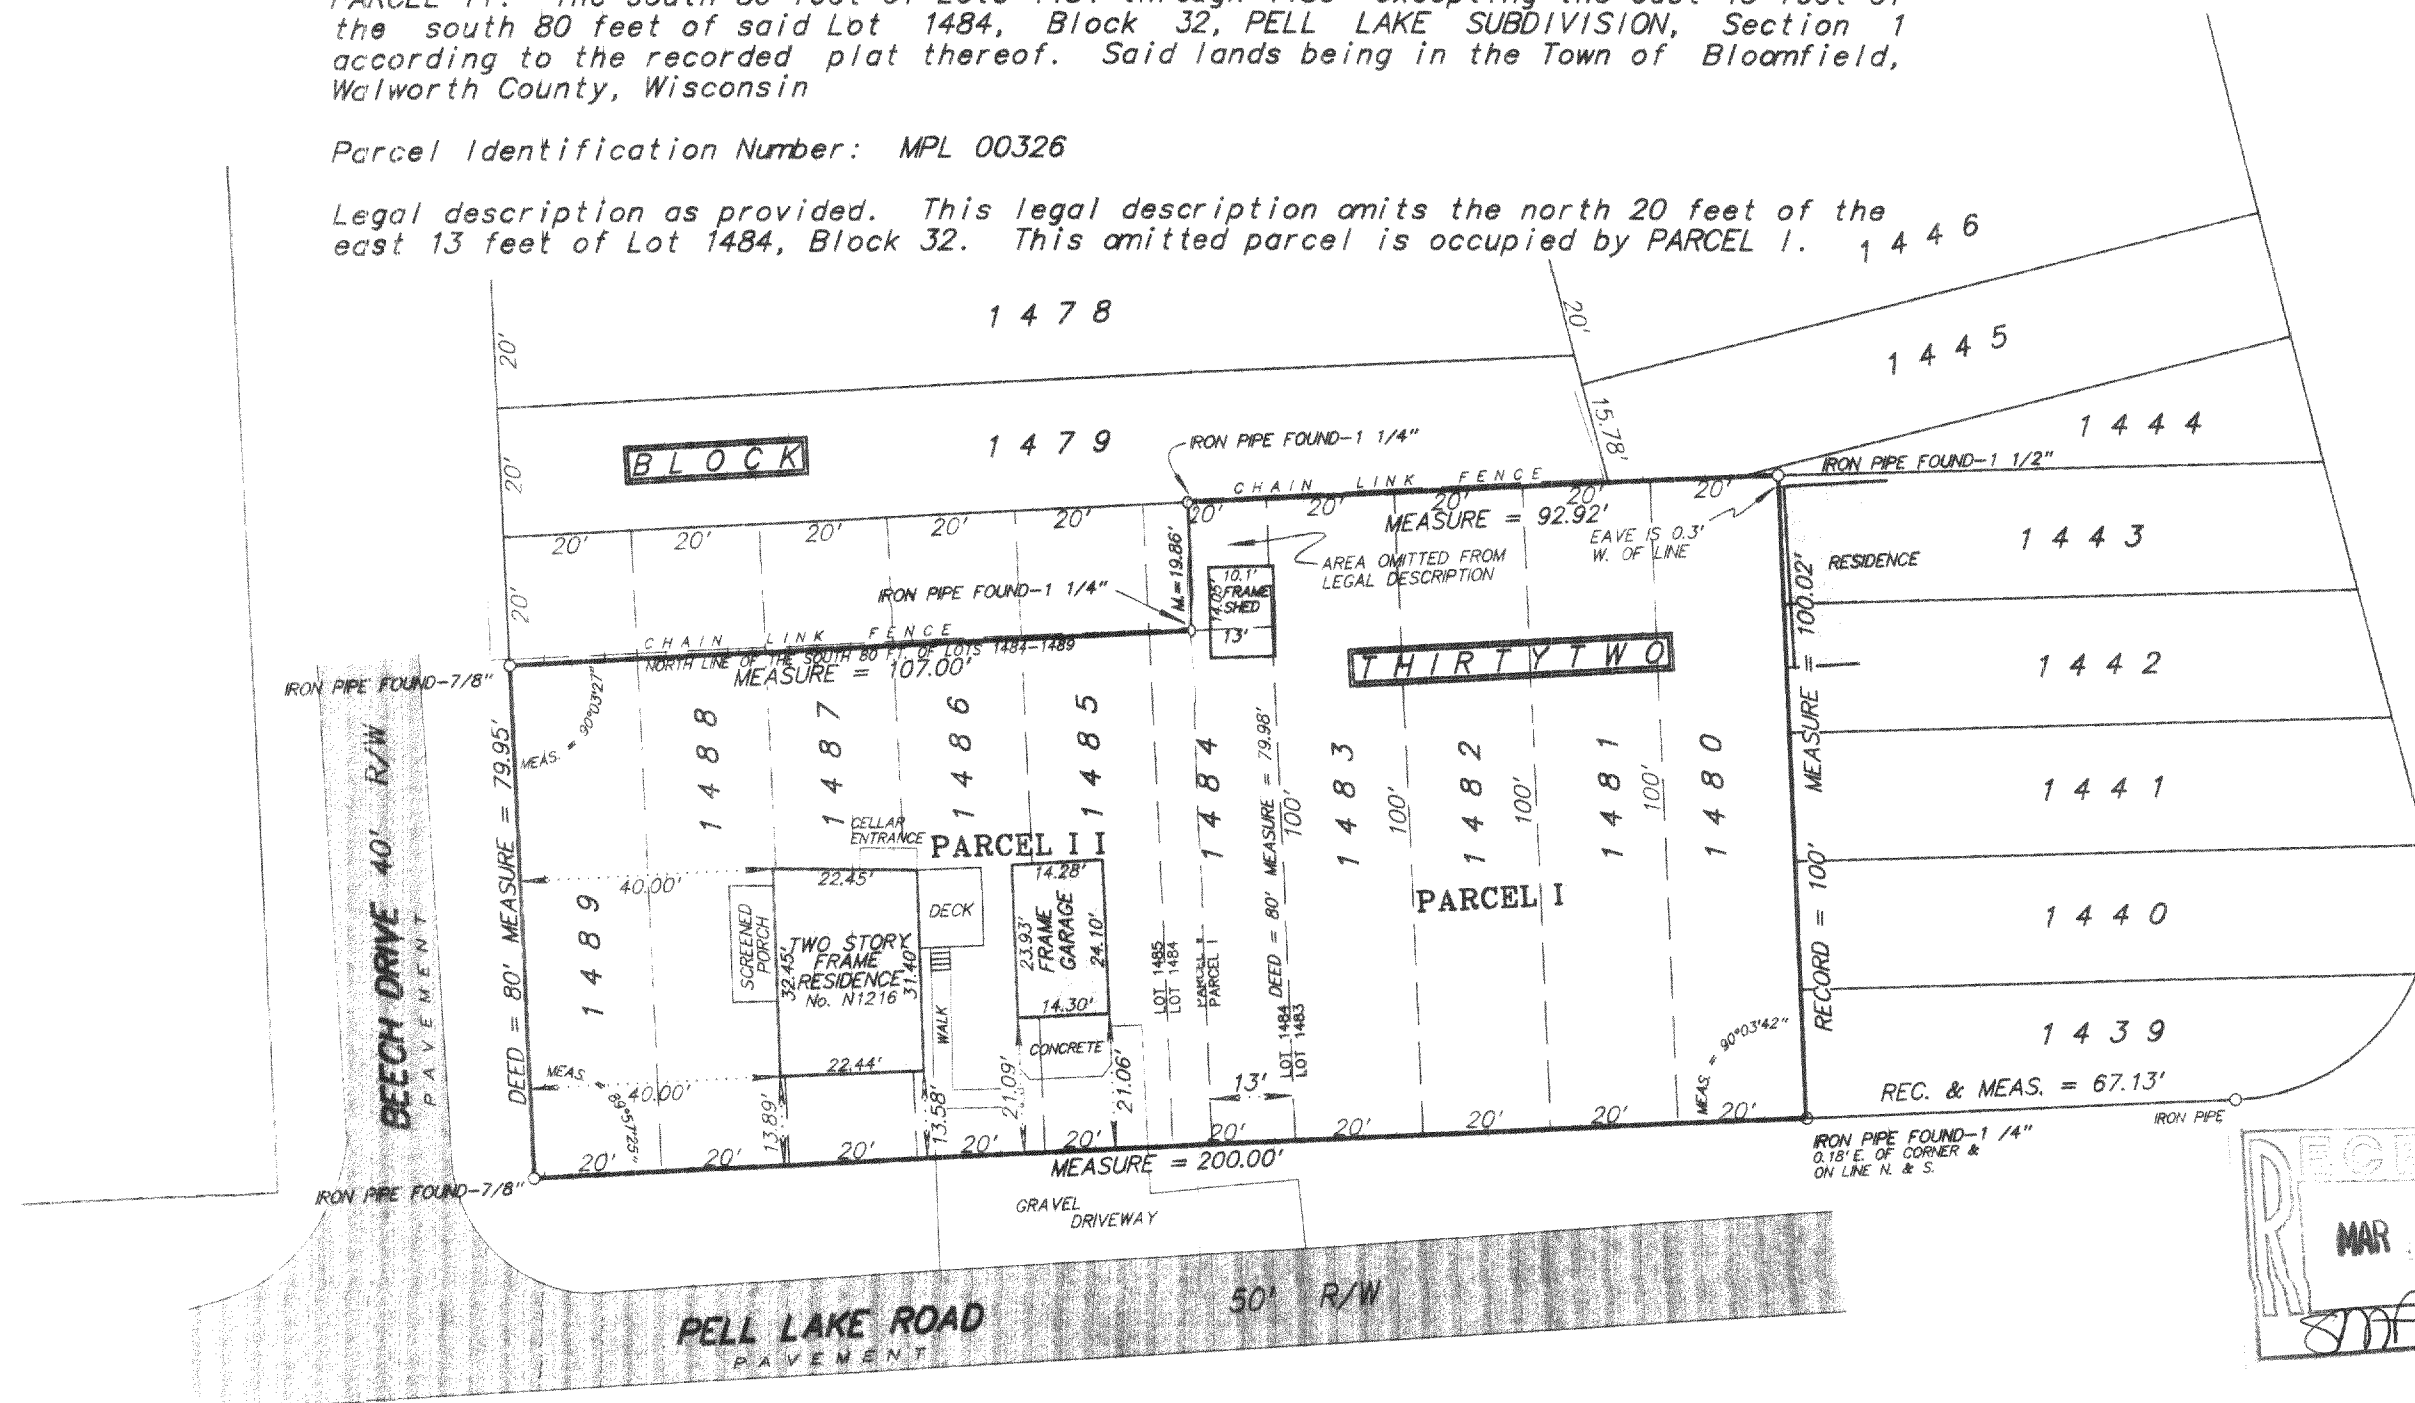

RECEIVED
MAR 3 2003
SDF

Dated at Bassett, Wisconsin this _____ day of _____ 2001.

Mark A. Bolender
Wisconsin Registered Land Surveyor S - 1784

SCALE 1 inch = 30 feet

ORDERED BY D. Pierce / Pierce Builders

JOB NO. 05226

MPL-325 MPL-326

118-2690