

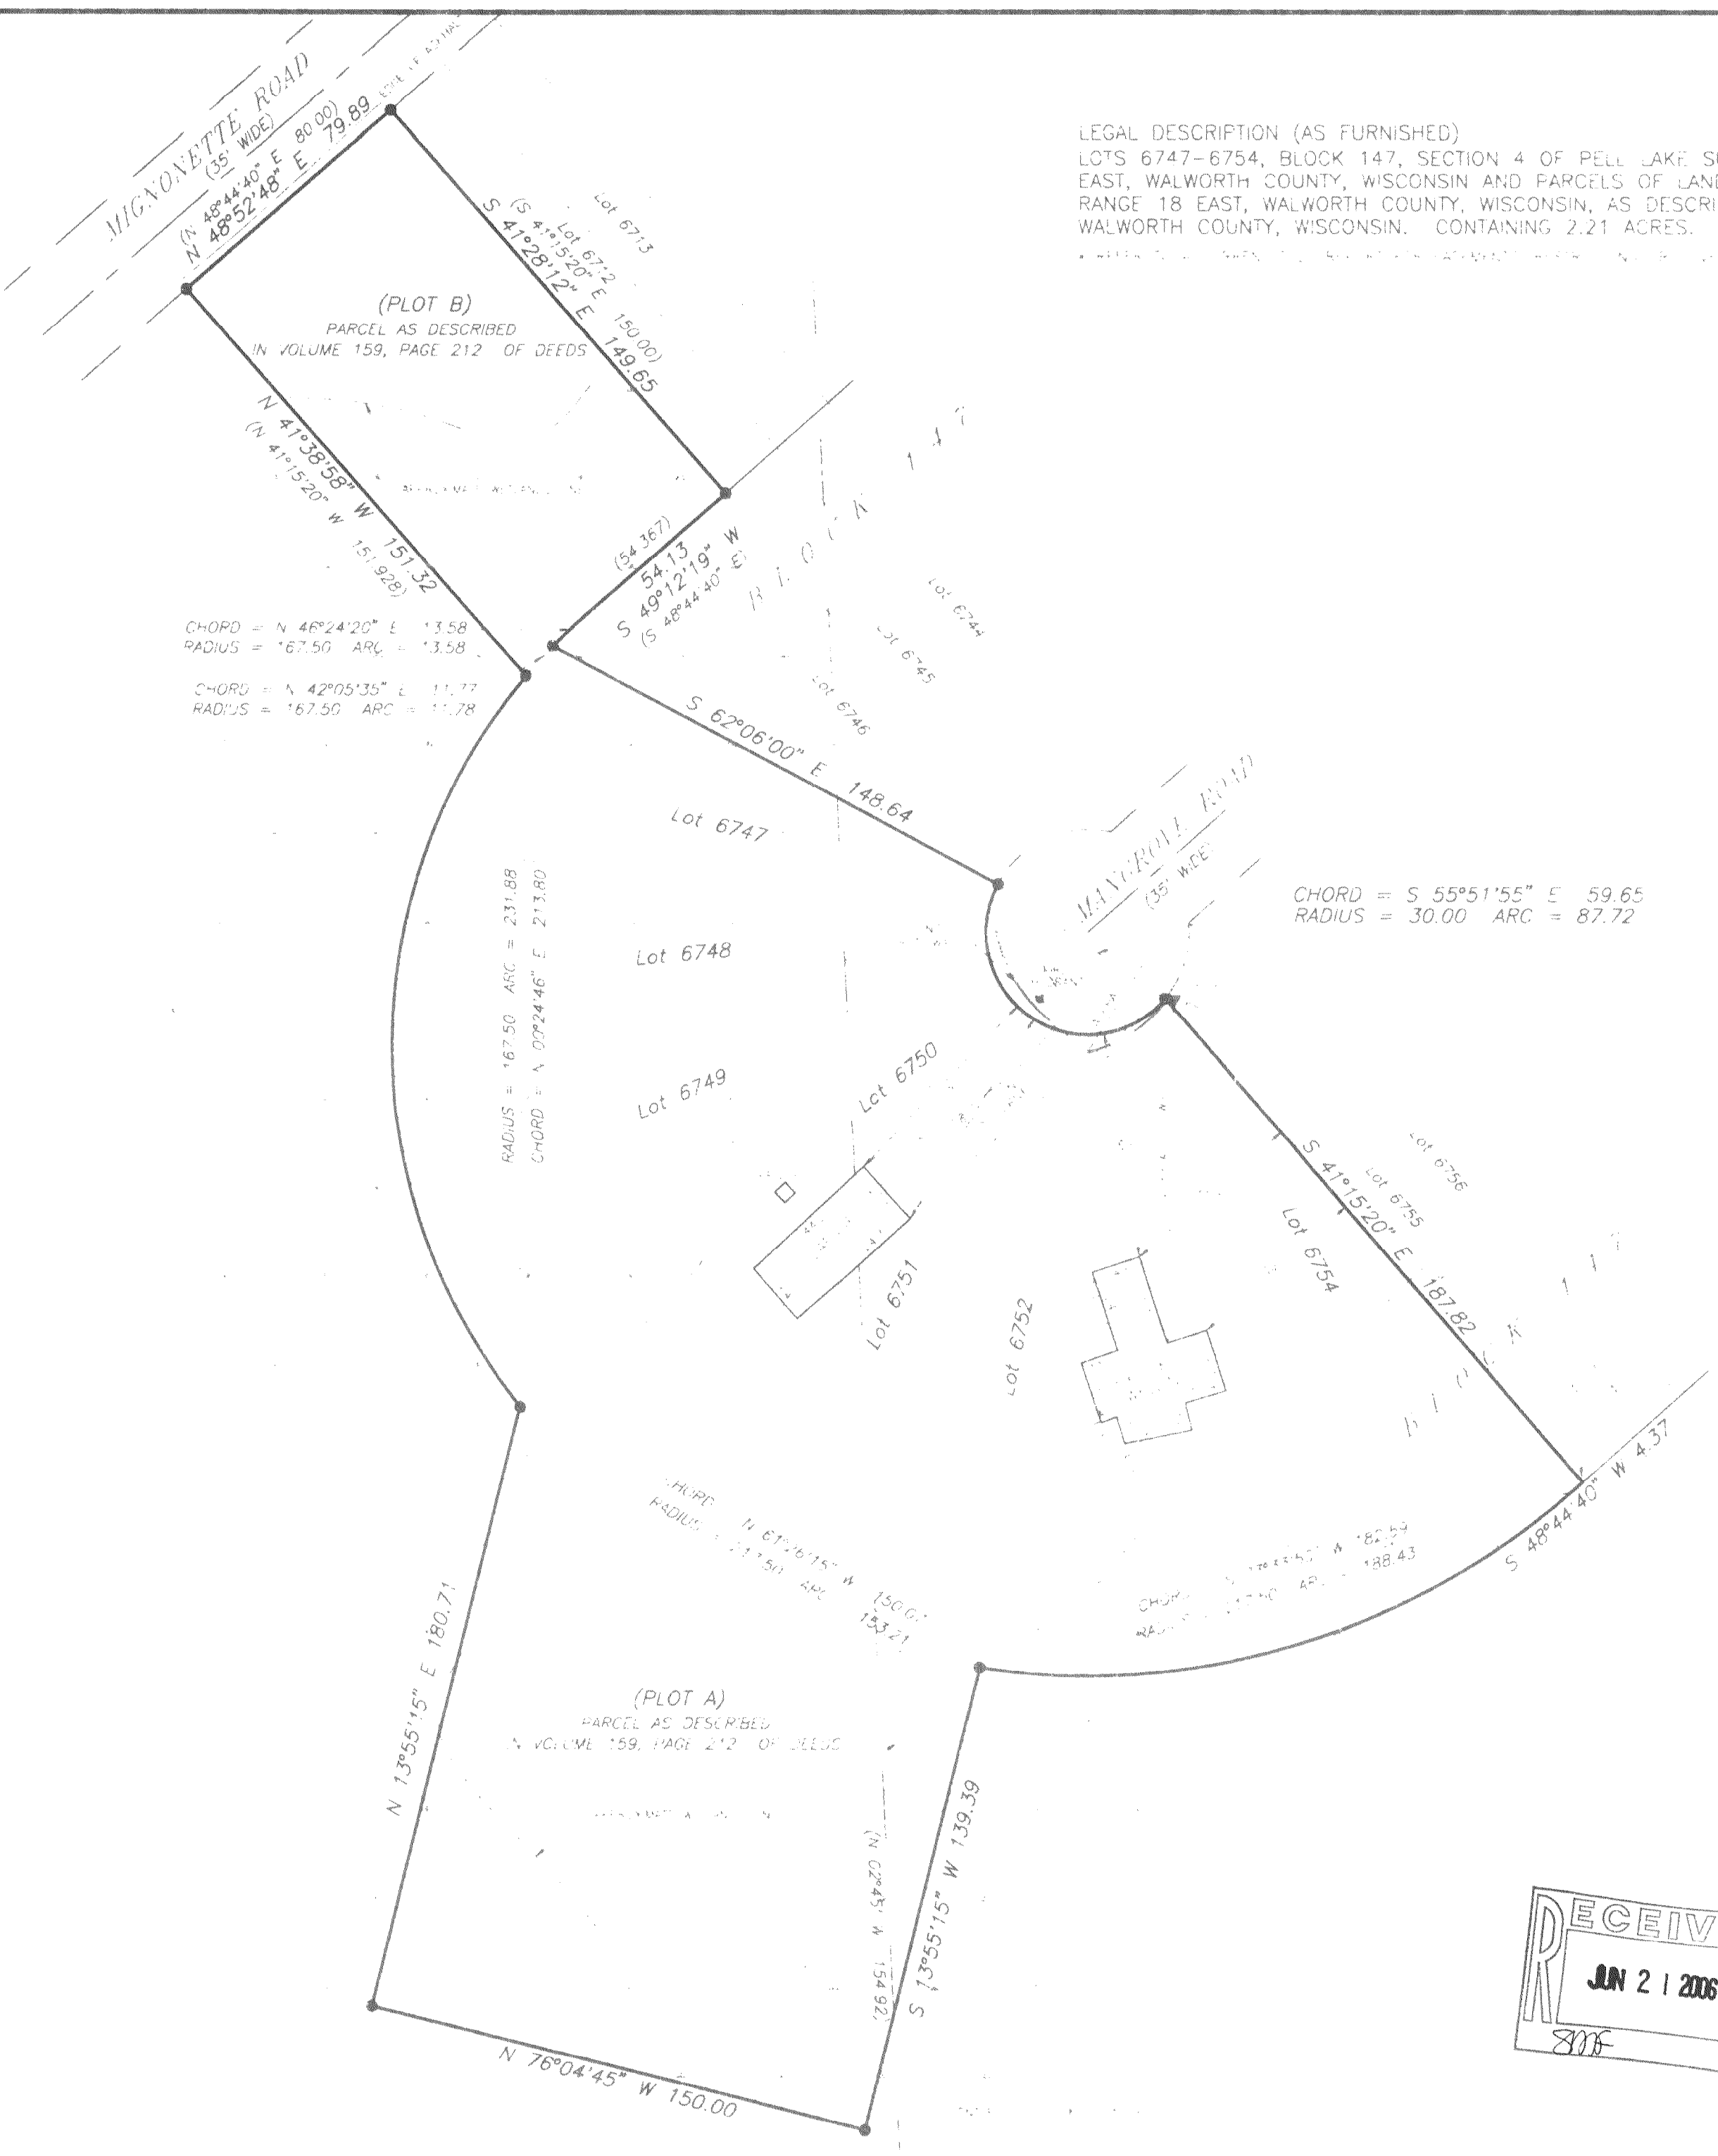


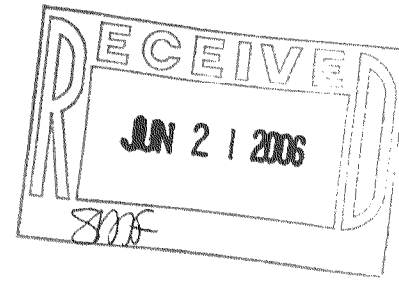

PROJECT
 PLAT OF SURVEY
 PROJECT NO.
 059337
 059337S1.DWG
 DATE
 NOVEMBER 23, 2005
 REVISIONS
 SURVEYOR
 GARY B. FOAT
 DEGEN FOAT SURVEYING LLC
 (262) 534-5404 / FAX 534-2022
 PREPARED FOR
 MICKY HORGAN
 REMAX/SOUTHERN LAKES
 112 ELIZABETH LANE
 GENOA CITY, WI 53128
 SCALE
 1" = 40'

DEGEN FOAT SURVEYING LLC
 100 SOUTH SECOND STREET
 WATERFORD, WISCONSIN 53185
 (262) 534-5404 (FAX) 534-2022

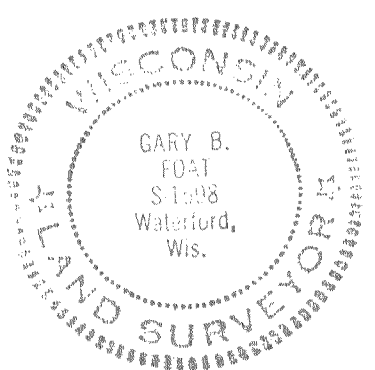

WALWORTH COUNTY, WISCONSIN
 NOVEMBER 23, 2005
 Gary B. Foat

MPL-1471

118-2732