

HAROLD H. KOLB

REGISTERED PROFESSIONAL LAND SURVEYOR
LAKE GENEVA, WISCONSIN


ROAD

WISTERIA

MAGNOLIA
ROAD

DRIVE

MULBERRY

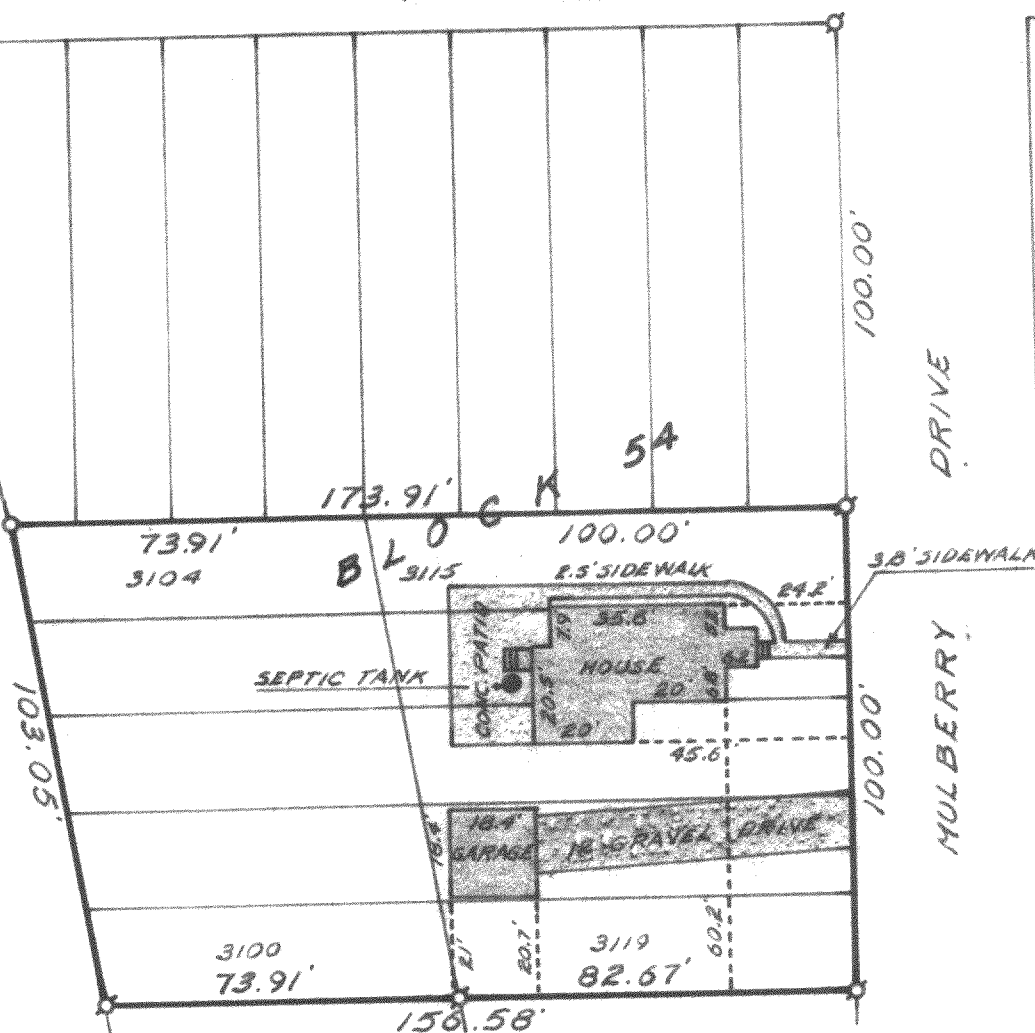

N



SCALE: 1" = 40'

LEGEND

- ⊗ - IRON PIPE FOUND
- - IRON PIPE PLACED
- - CONCRETE MONUMENT
- x - SPIKE

PLAT OF SURVEY OF

Lots 3100-3104 inclusive and 3115-3119
inclusive, Block 54, Map of Section 2,
Pell Lake Subd., T 1 N, R 18 E, Walworth
County, Wisconsin showing all apparent
improvements.

I, HAROLD H. KOLB, DO HEREBY CERTIFY THAT I HAVE
SURVEYED THE PROPERTY HEREON DESCRIBED ACCORDING
TO THE OFFICIAL RECORDS, AND THAT THE PLAT HEREON
IS A CORRECT REPRESENTATION OF THE LOT LINES.


Harold H. Kolb

HAROLD H. KOLB

WISCONSIN REGISTERED LAND SURVEYOR, S-187

DATE November 22, 1969

Revised Jan. 28, 1970

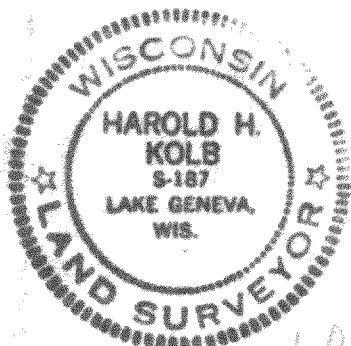

LRVD/ MPL-646 649

118-285