


#73-70

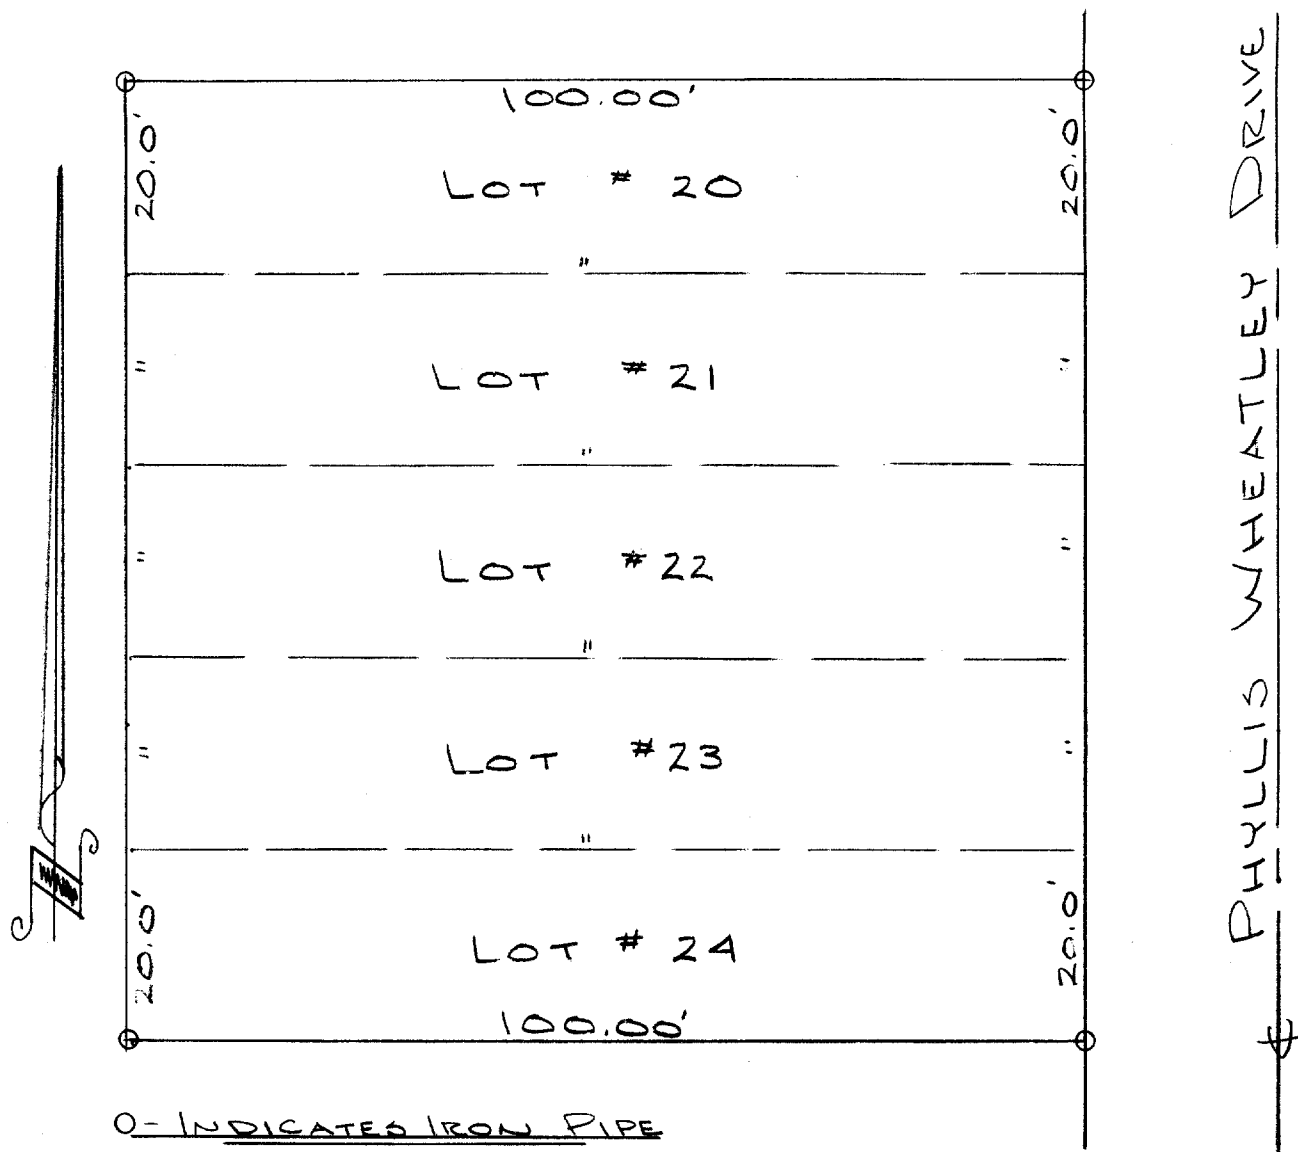

DESCRIPTION:


Lots 20, 21, 22, 23, and 24 Block 8, Lake Ivanhoe Resort a subdivision in Section 23, Town 1 north, Range 18 east, Walworth County, Wisconsin.

CERTIFICATE:

I, James F. Biagi, surveyor, do hereby certify that I have surveyed the property hereon described.

Dated: June 12th 1970.

James F. Biagi RLS 272  
Elkhorn, Wis.

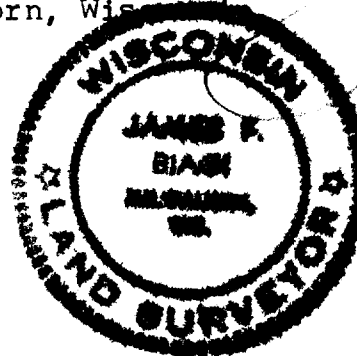

MIR-126

118-289