


92-70

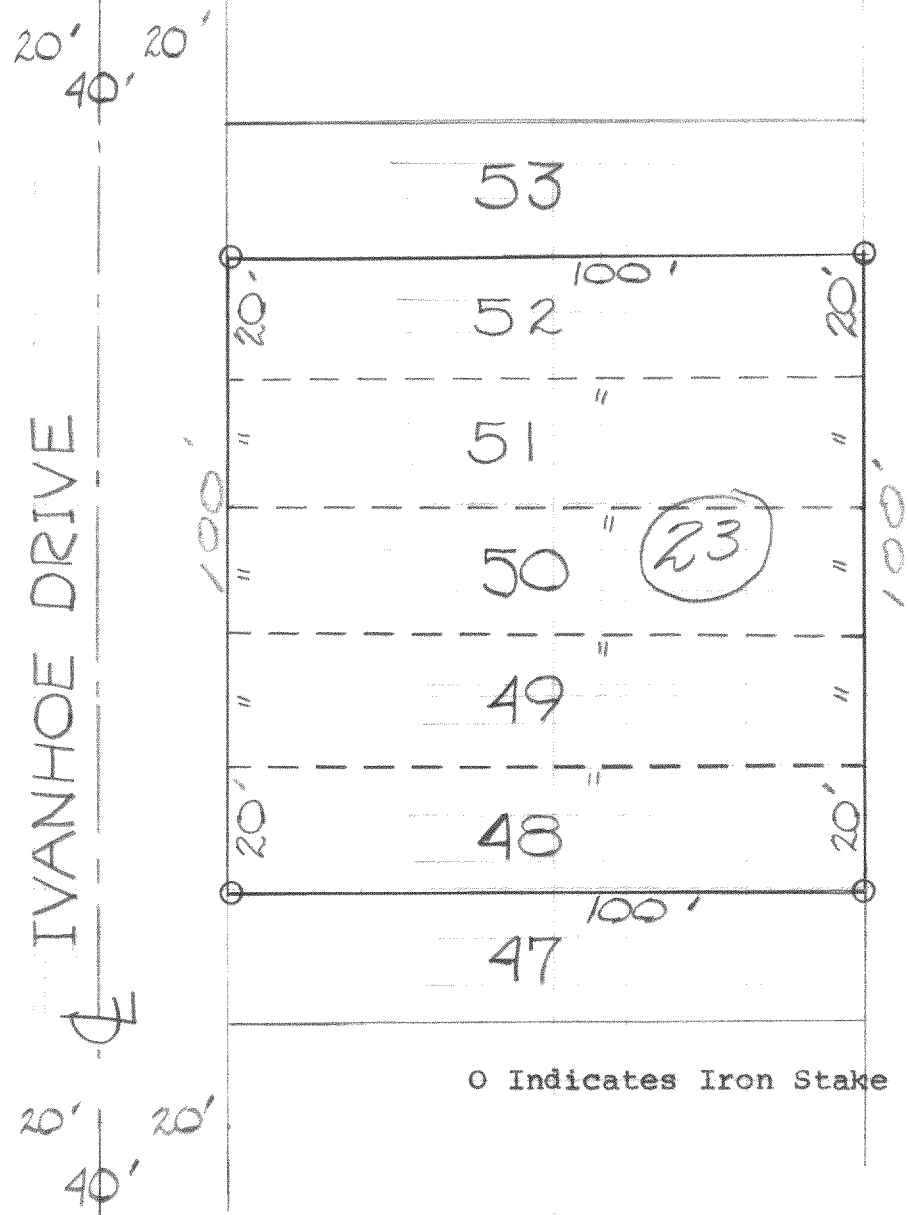

DESCRIPTION:

Lots 48, 49, 50, 51, and 52 Block 23 Lake Ivanhoe Resort
a subdivision in Section 23 Town 1 north Range 18 east,
Walworth County, Wisconsin.

CERTIFICATE: I, James F. Biagi surveyor, do hereby certify that
I have surveyed the property hereon described.

Date: June 1st 1970.

James F. Biagi, RLS 272
Elkhorn, Wisconsin.

