


# ~~91-20~~

20' 20'  
40'

PHYLLIS WHEATLEY DRIVE

4

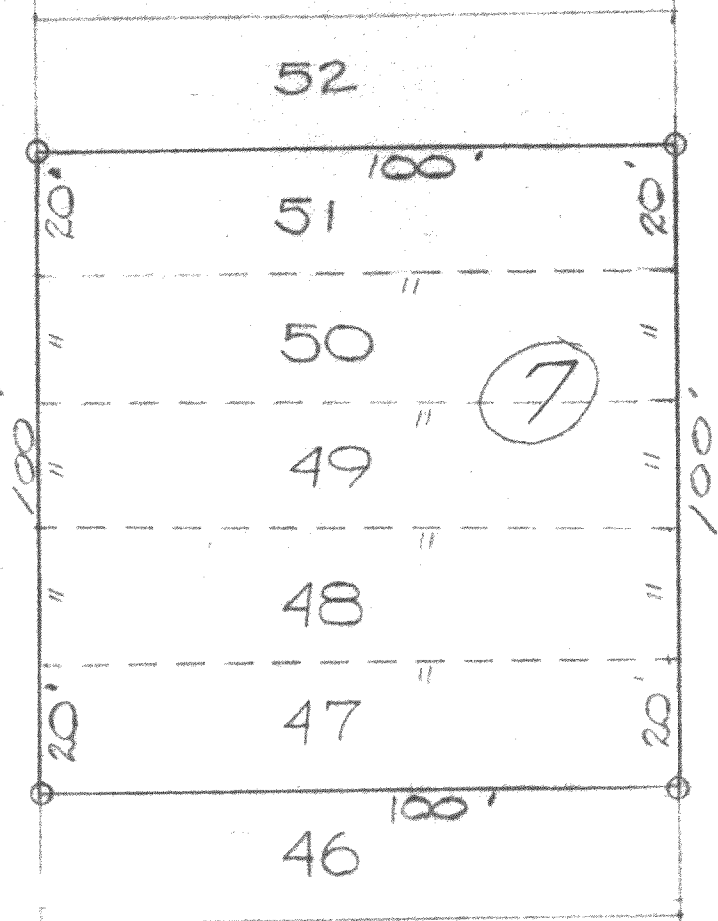

○ Indicates Iron Stake.


20' 20'  
40'

DESCRIPTION: Lots 47, 48, 49, 50 and 51 Block 7 Lake Ivanhoe Resort a subdivision in Section 23, Town 1 north, Range 18 east, Walworth County, Wisconsin.

CERTIFICATE: I, James F. Biagi surveyor do hereby certify that I have surveyed the property hereon described.

Date: June 1st 1970.

James F. Biagi, BLS 272  
Elkhorn, Wisconsin.

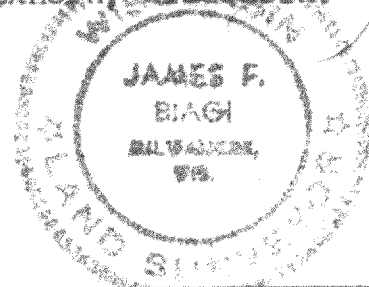

MIR-116 CRVD

118-297