


PLAT OF SURVEY -OF-

LOT 16, WM. ELLIOTTS POWERS LAKE SUBDIVISION, LOCATED IN THE NORTHEAST
FRACTIONAL 1/4 OF SECTION 13, TOWNSHIP 1 NORTH, RANGE 18 EAST OF THE TOWN OF
BLOOMFIELD, WALWORTH COUNTY, WISCONSIN.

SURVEY FOR: ERICA MCKOANE


SURVEY LOCATION: W187 LAKE STREET

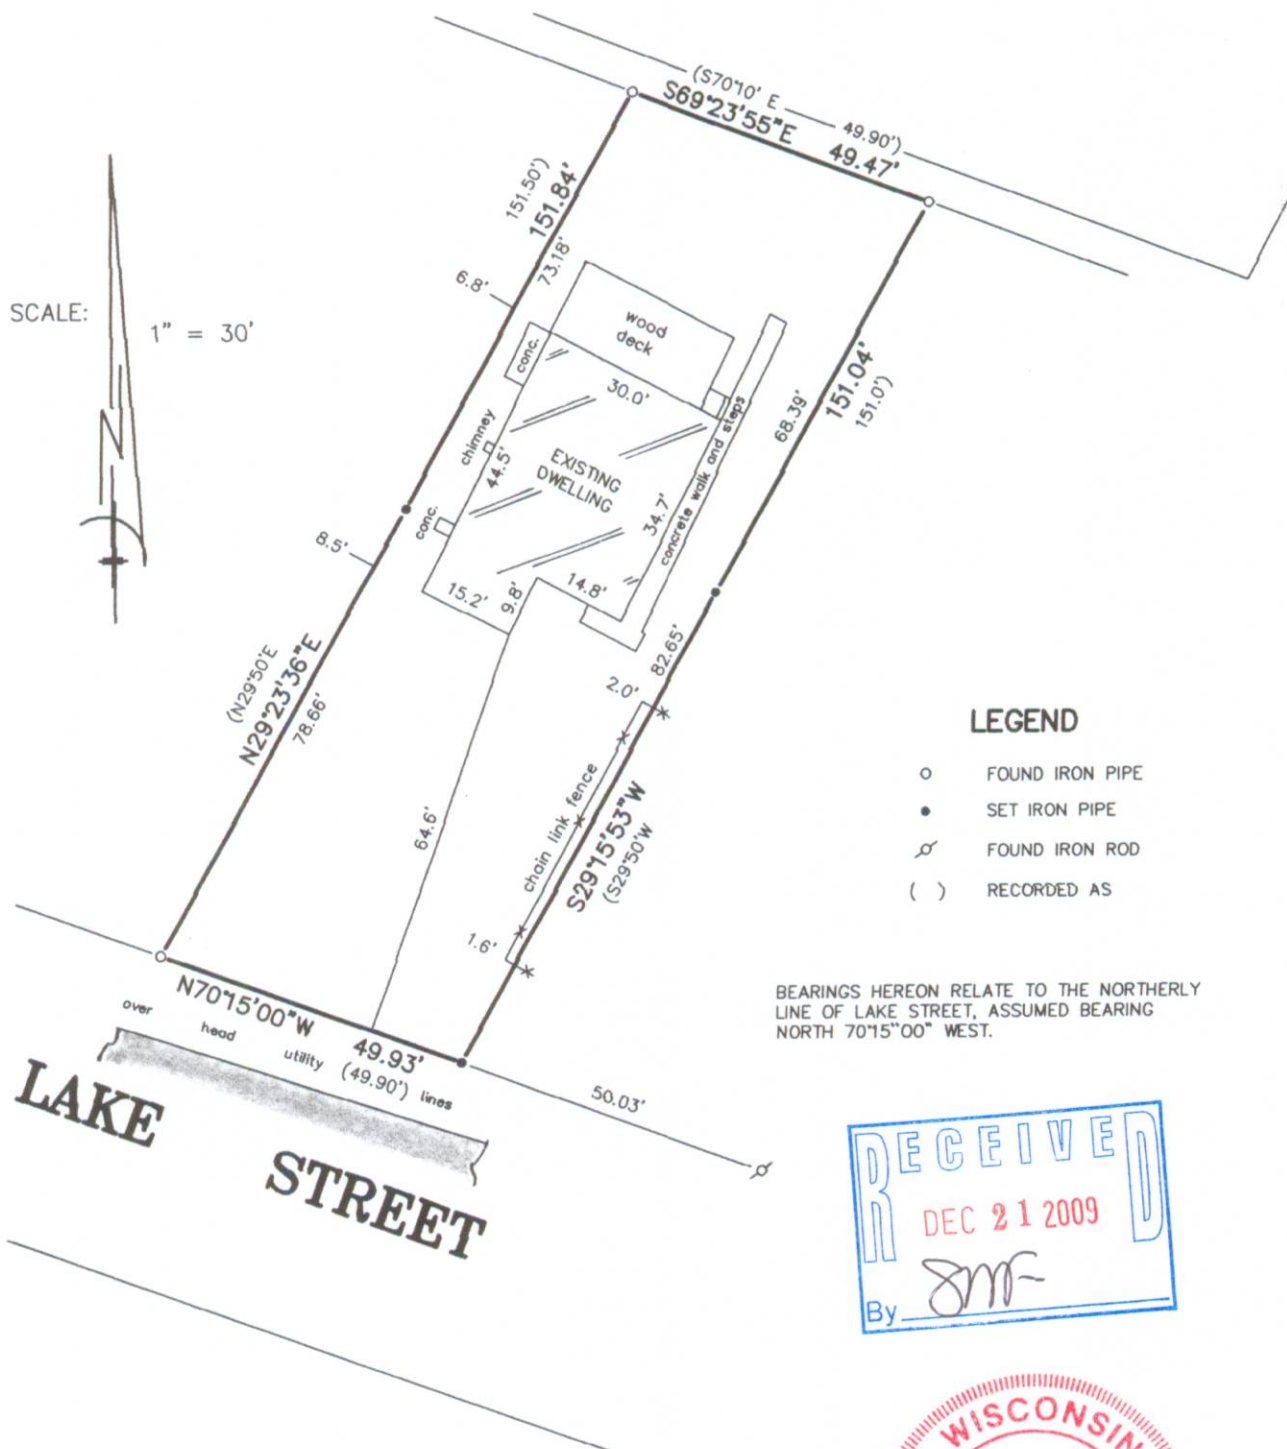

LEGEND

- FOUND IRON PIPE
- SET IRON PIPE
- ✕ FOUND IRON ROD
- () RECORDED AS

BEARINGS HEREON RELATE TO THE NORTHERLY
LINE OF LAKE STREET, ASSUMED BEARING
NORTH 70°15'00" WEST.

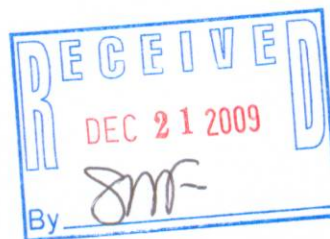

"I hereby certify that I have surveyed the above described property and that the above map is a correct representation thereof and shows the size and location of the property, its exterior boundaries, the location of all visible structures and dimensions of all principal buildings thereon, boundary fences, apparent easements, roadways and encroachments, if any."

"This survey is made for the use of the present owners of the property, and those who purchase, mortgage, or guarantee the title thereto within one year from date hereof."

THIS IS NOT AN ORIGINAL PRINT
UNLESS THIS SEAL IS RED.



B.W. SURVEYING, INC.

412 N. PINE STREET
BURLINGTON, WI 53105
(262)-767-0225

Robert J. Wetzel
ROBERT J. WETZEL S-1778

AUGUST 13, 2009
DATE

8084
JOB NUMBER

ME-16

118-2992