
PREPARED FOR: VICTOR MANELLA W1018 SUNVIEW RD GENOA CITY, WI 53127

ASBUILT SURVEY

- OF -

PATHFINDER SURVEYING, INC. W2888 KRUEGER ROAD UNIT "D' LAKE GENEVA, WI 53147 (262) 248-8303

LOTS 6097 THROUGH 6100, IN BLOCK 135 OF PELL LAKE SUBDIVISION, LOCATED IN TOWN 1 NORTH, RANGE 18 EAST, WALWORTH COUNTY, WISCONSIN

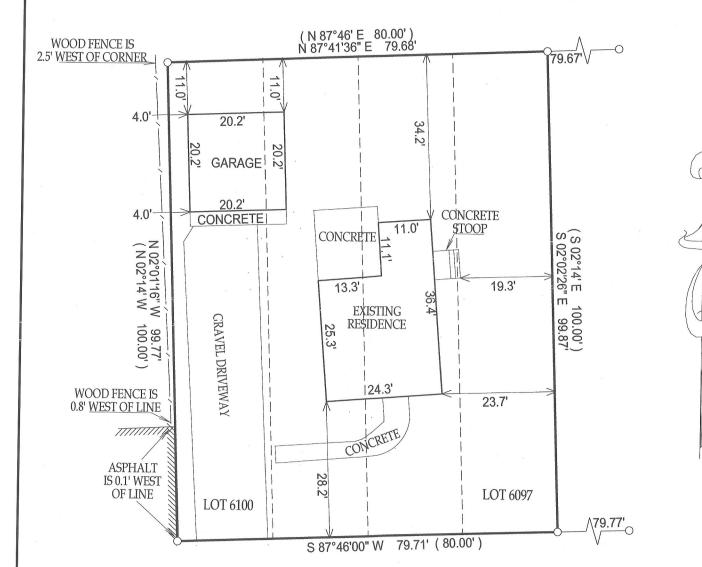

GOLDEN GLOW ROAD

(40' WIDE)



() = RECORDED AS

 $\Box = FOUND IRON BAR$

○ = FOUND IRON PIPE

■ = SET IRON BAR

- OLI INON DIIN

= SET IRON PIPE

SCALE: 1" = 20'

JOB #: 09-014

TAX ID #: MPL 01327

COMPARE LEGAL DESCRIPTION ABOVE AND DRAWING WITH DEED. FOR BUILDING RESTRICTIONS AND EASEMENTS NOT SHOWN, REFER TO DEED, ABSTRACT SOURCES AND LOCAL MUNICIPAL CODES. NOTIFY THE SURVEYOR IMMEDIATELY OF ANY DISCREPANCY.

"I hereby certify that I have surveyed the above described property and that the above map, to the best of my knowledge and belief, is a true representation thereof and shows the size and location of all visible structures, apparent easements and encroachments if any." This survey is made for the present owners of the property, and those who purchase, mortgage, or guarantee the title thereto, within one year from the date hereof.

NOTE: BASIS OF BEARING IS THE RECORD PLAT OF PELL LAKE.

REVISED 6/10/2009, ASBUILT GARAGE DATED THIS 24th DAY OF MARCH, 2009.

JEFFREY L KIMPS S - 2436 Wisconsin Registered Land Surveyor (original if signed in red)

NISCONS

KIMPS

VIS.

SUR'

118-3020