




PREPARED FOR:
GREGORY BOCHIAK
N1373 THISTLE DR.
GENOA CITY, WI. 53128

PLAT OF SURVEY

- OF -

PATHFINDER SURVEYING INC.
(formerly)
J.K. SURVEYING INC.
P.O. BOX 322
LAKE GENEVA, WI.
262-248-8303

LOTS 5178, 5179, 5180, 5181, 5182, 5183 AND 5184, BLOCK 105
OF PELL LAKE SECTION 3, A SUBDIVISION LOCATED IN TOWN
1 NORTH, RANGE 18 EAST, TOWN OF BLOOMFIELD, COUNTY
OF WALWORTH AND STATE OF WISCONSIN.

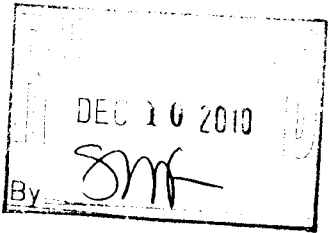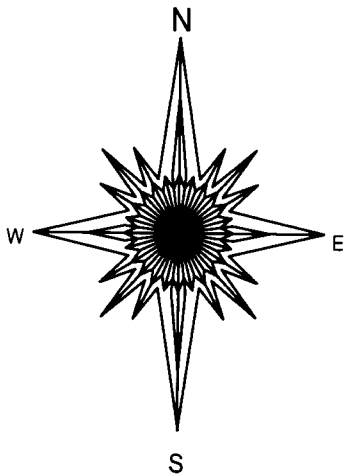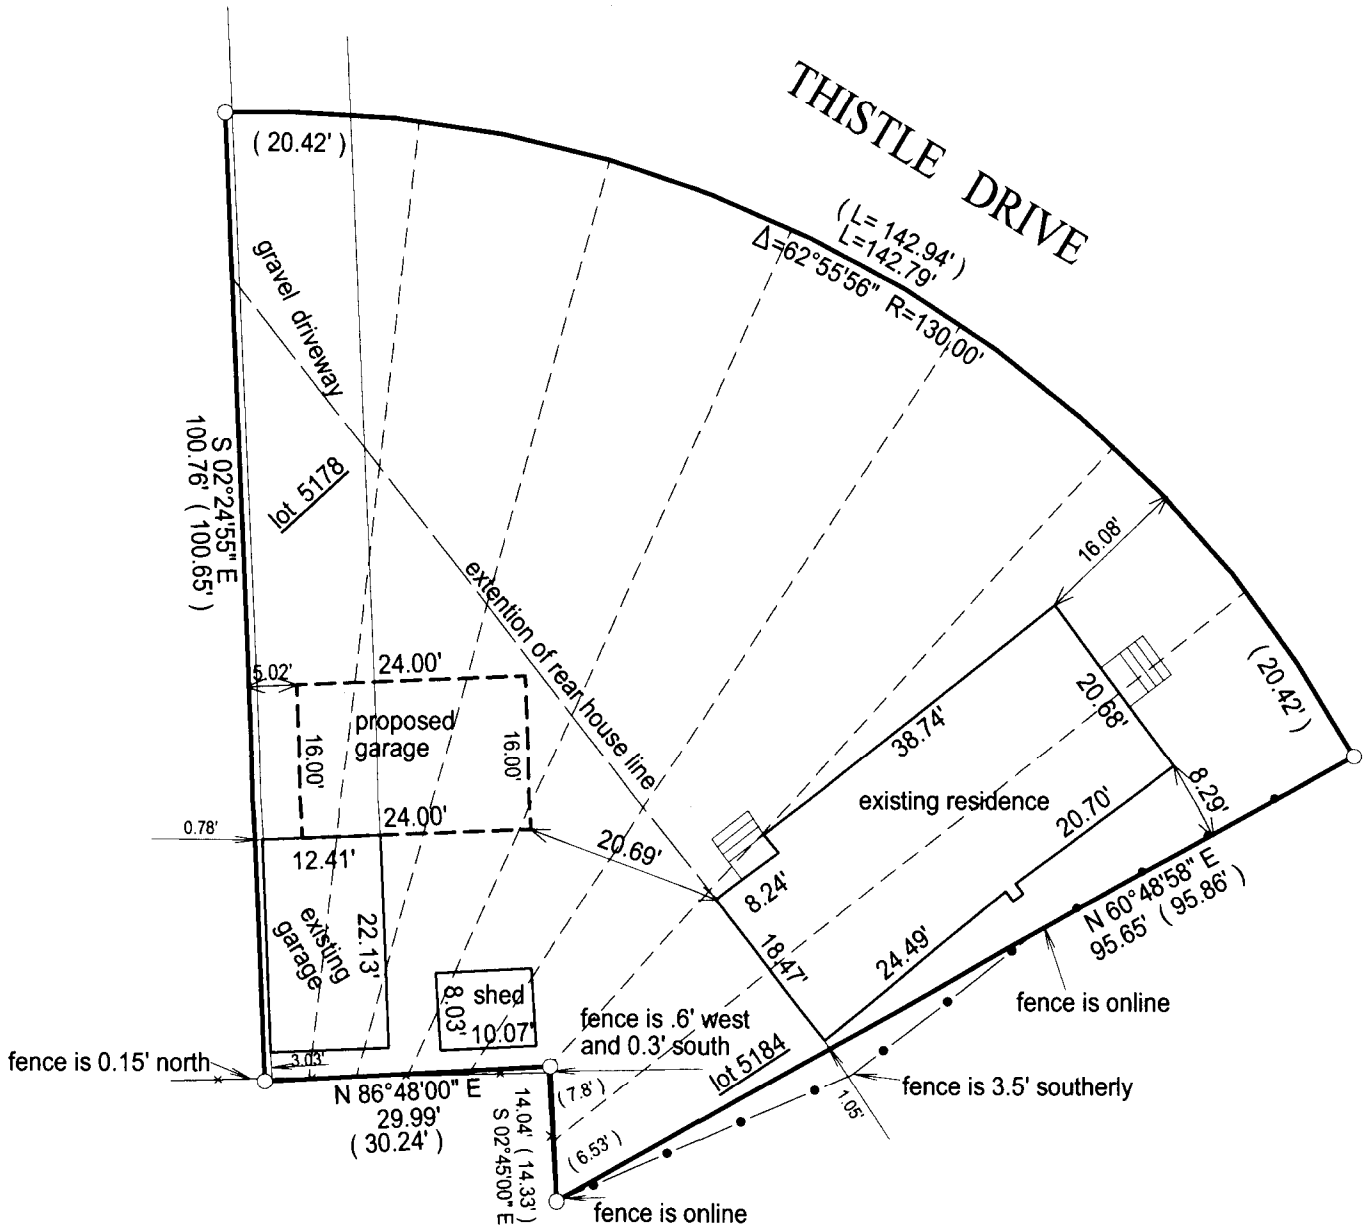

- () = recorded as
- = found iron bar
- = found iron pipe
- = set iron pipe
- = set iron bar

SCALE 1" = 20'

JOB # 10-129

TAX ID #


MPL 0113

BASIS OF BEARING OF THIS PLAT: THE SOUTHERLY
EAST - WEST LINE OF THE ABOVE PARCELS WAS ASSUMED
TO BEAR N86°48' 00" E.

"I hereby certify that I have surveyed the above described property and that the above map is a true representation of its exterior boundary and shows the size and location of all visible structures, apparent easements and encroachments if any."

This survey is made for the present owners of the property, and those who purchase, mortgage, or guarantee the title thereto, within one year from the date hereof.

DATED THIS 1ST DAY OF SEPTEMBER, 2010.

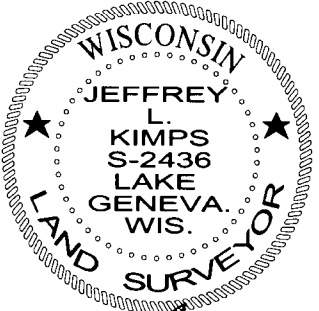

JEFFREY L KIMPS S - 2436
Wisconsin Registered Land Surveyor
(original if signed in red)