


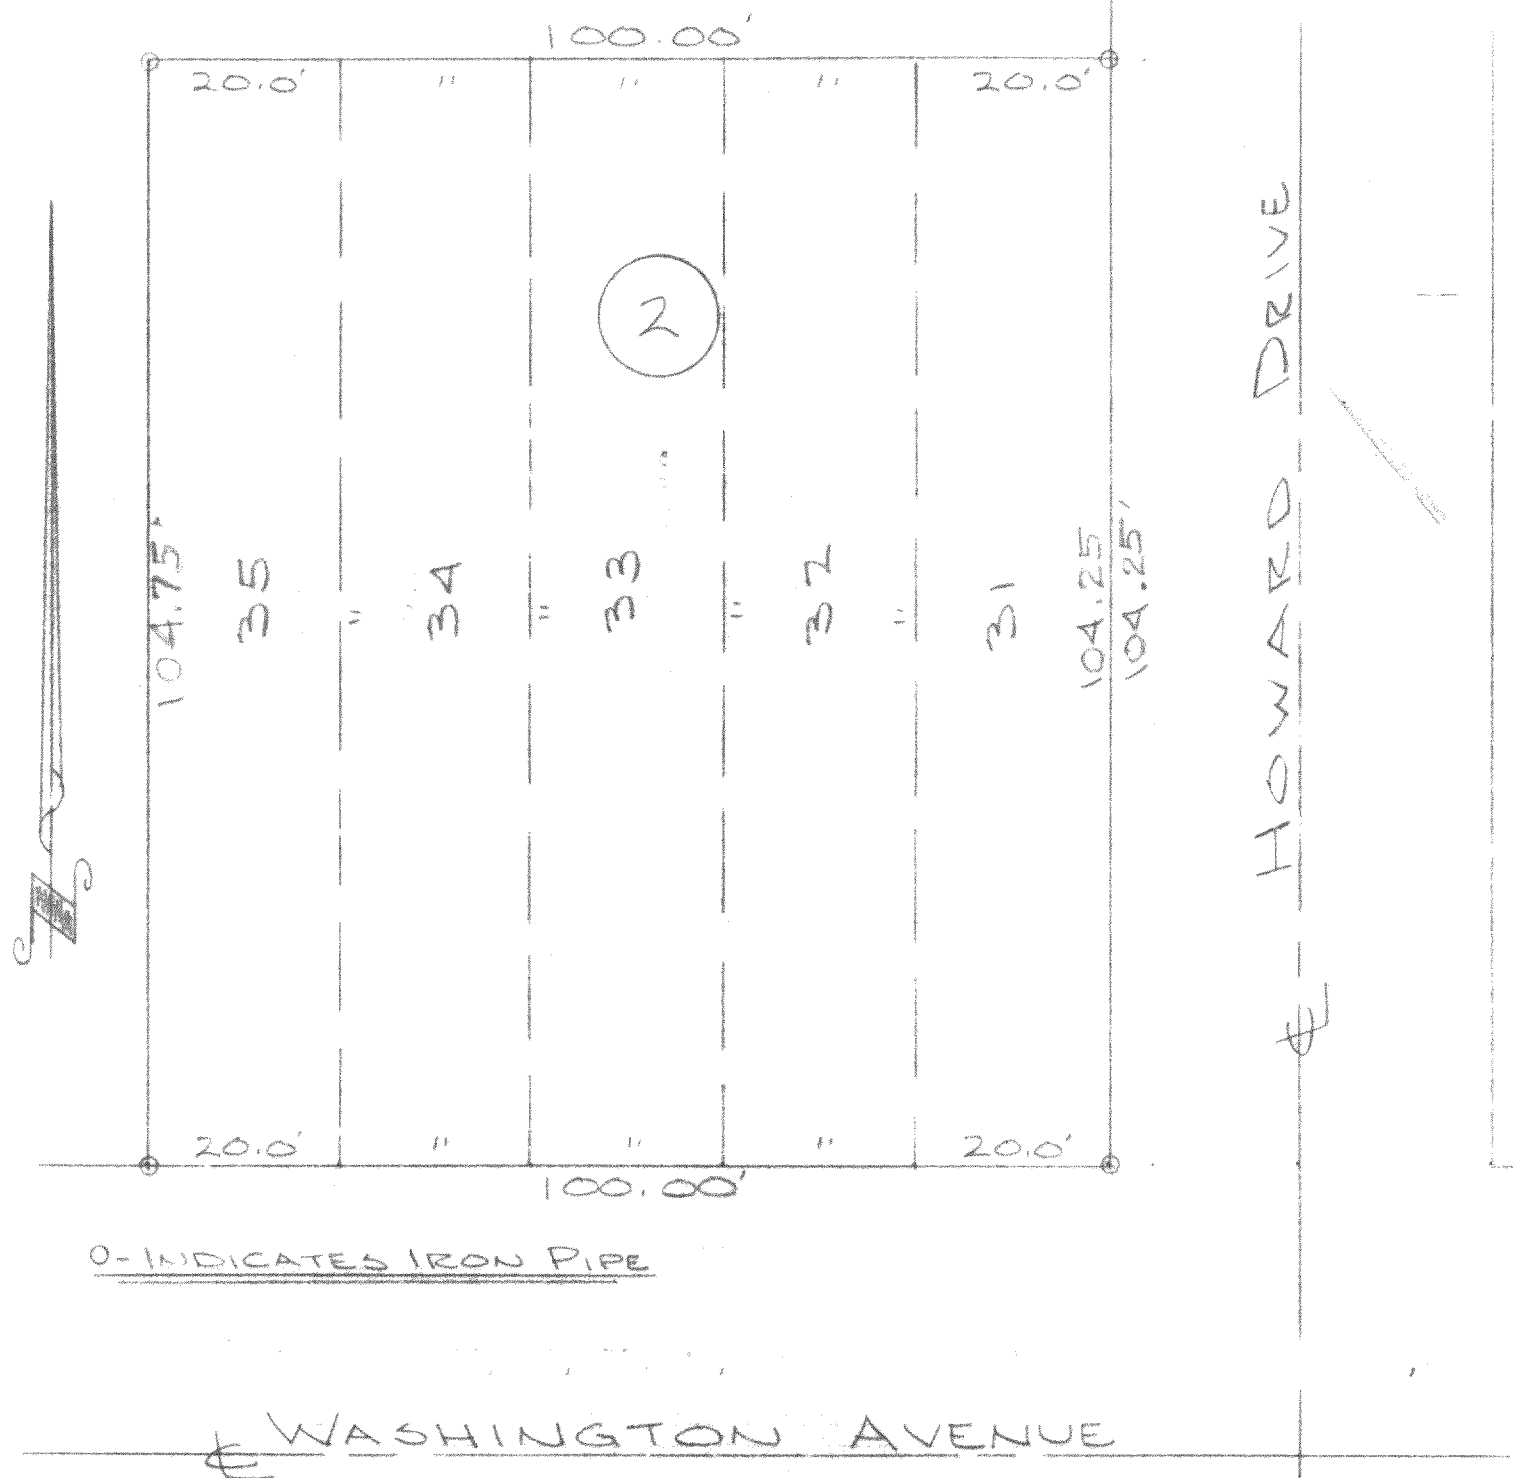

DESCRIPTION: Lots 31, 32, 33, 34, and 35 Block 2, Lake Ivanhoe Resort, a subdivision in Section 23 Town 1 north, Range 18 east, Bloomfield Township, Walworth County, Wisconsin.

CERTIFICATE: I, James F. Biagi Surveyor, do hereby certify that I have surveyed the property hereon described.

James F. Biagi RLS 272  
Elkhorn, Wisconsin.

Dated: August 25th 1970.