

PLAT OF SURVEY
-OF-




LOT 8 IN BLOCK 1 IN PART 1 OF THE FIRST ADDITION TO JEFFERSON ISLAND SUBDIVISION, A PART OF THE SOUTHEAST 1/4 OF SECTION 13, TOWNSHIP 1 NORTH, RANGE 18 EAST OF THE FOURTH PRINCIPAL MERIDIAN, AND LYING AND BEING IN THE VILLAGE OF BLOOMFIELD, COUNTY OF WALWORTH, STATE OF WISCONSIN.

SURVEY FOR: KEATING REAL ESTATE

SURVEY ADDRESS: W122 92nd STREET

NOTE: THIS MAP IS BEING REVISED TO CORRECT AN ERROR IN THE LEGAL DESCRIPTION WHICH READ "LYING AND BEING IN THE TOWN OF BLOOMFIELD", WHERE IT SHOULD HAVE READ "LYING AND BEING IN THE VILLAGE OF BLOOMFIELD".

BEARINGS HEREON RELATE TO THE EASTERLY LINE OF LOT 8 IN BLOCK 1 OF PART ONE OF THE FIRST ADDITION TO JEFFERSON ISLAND SUBDIVISION. ASSUMED BEARING OF SOUTH 26°25'40" WEST AS PLATTED.

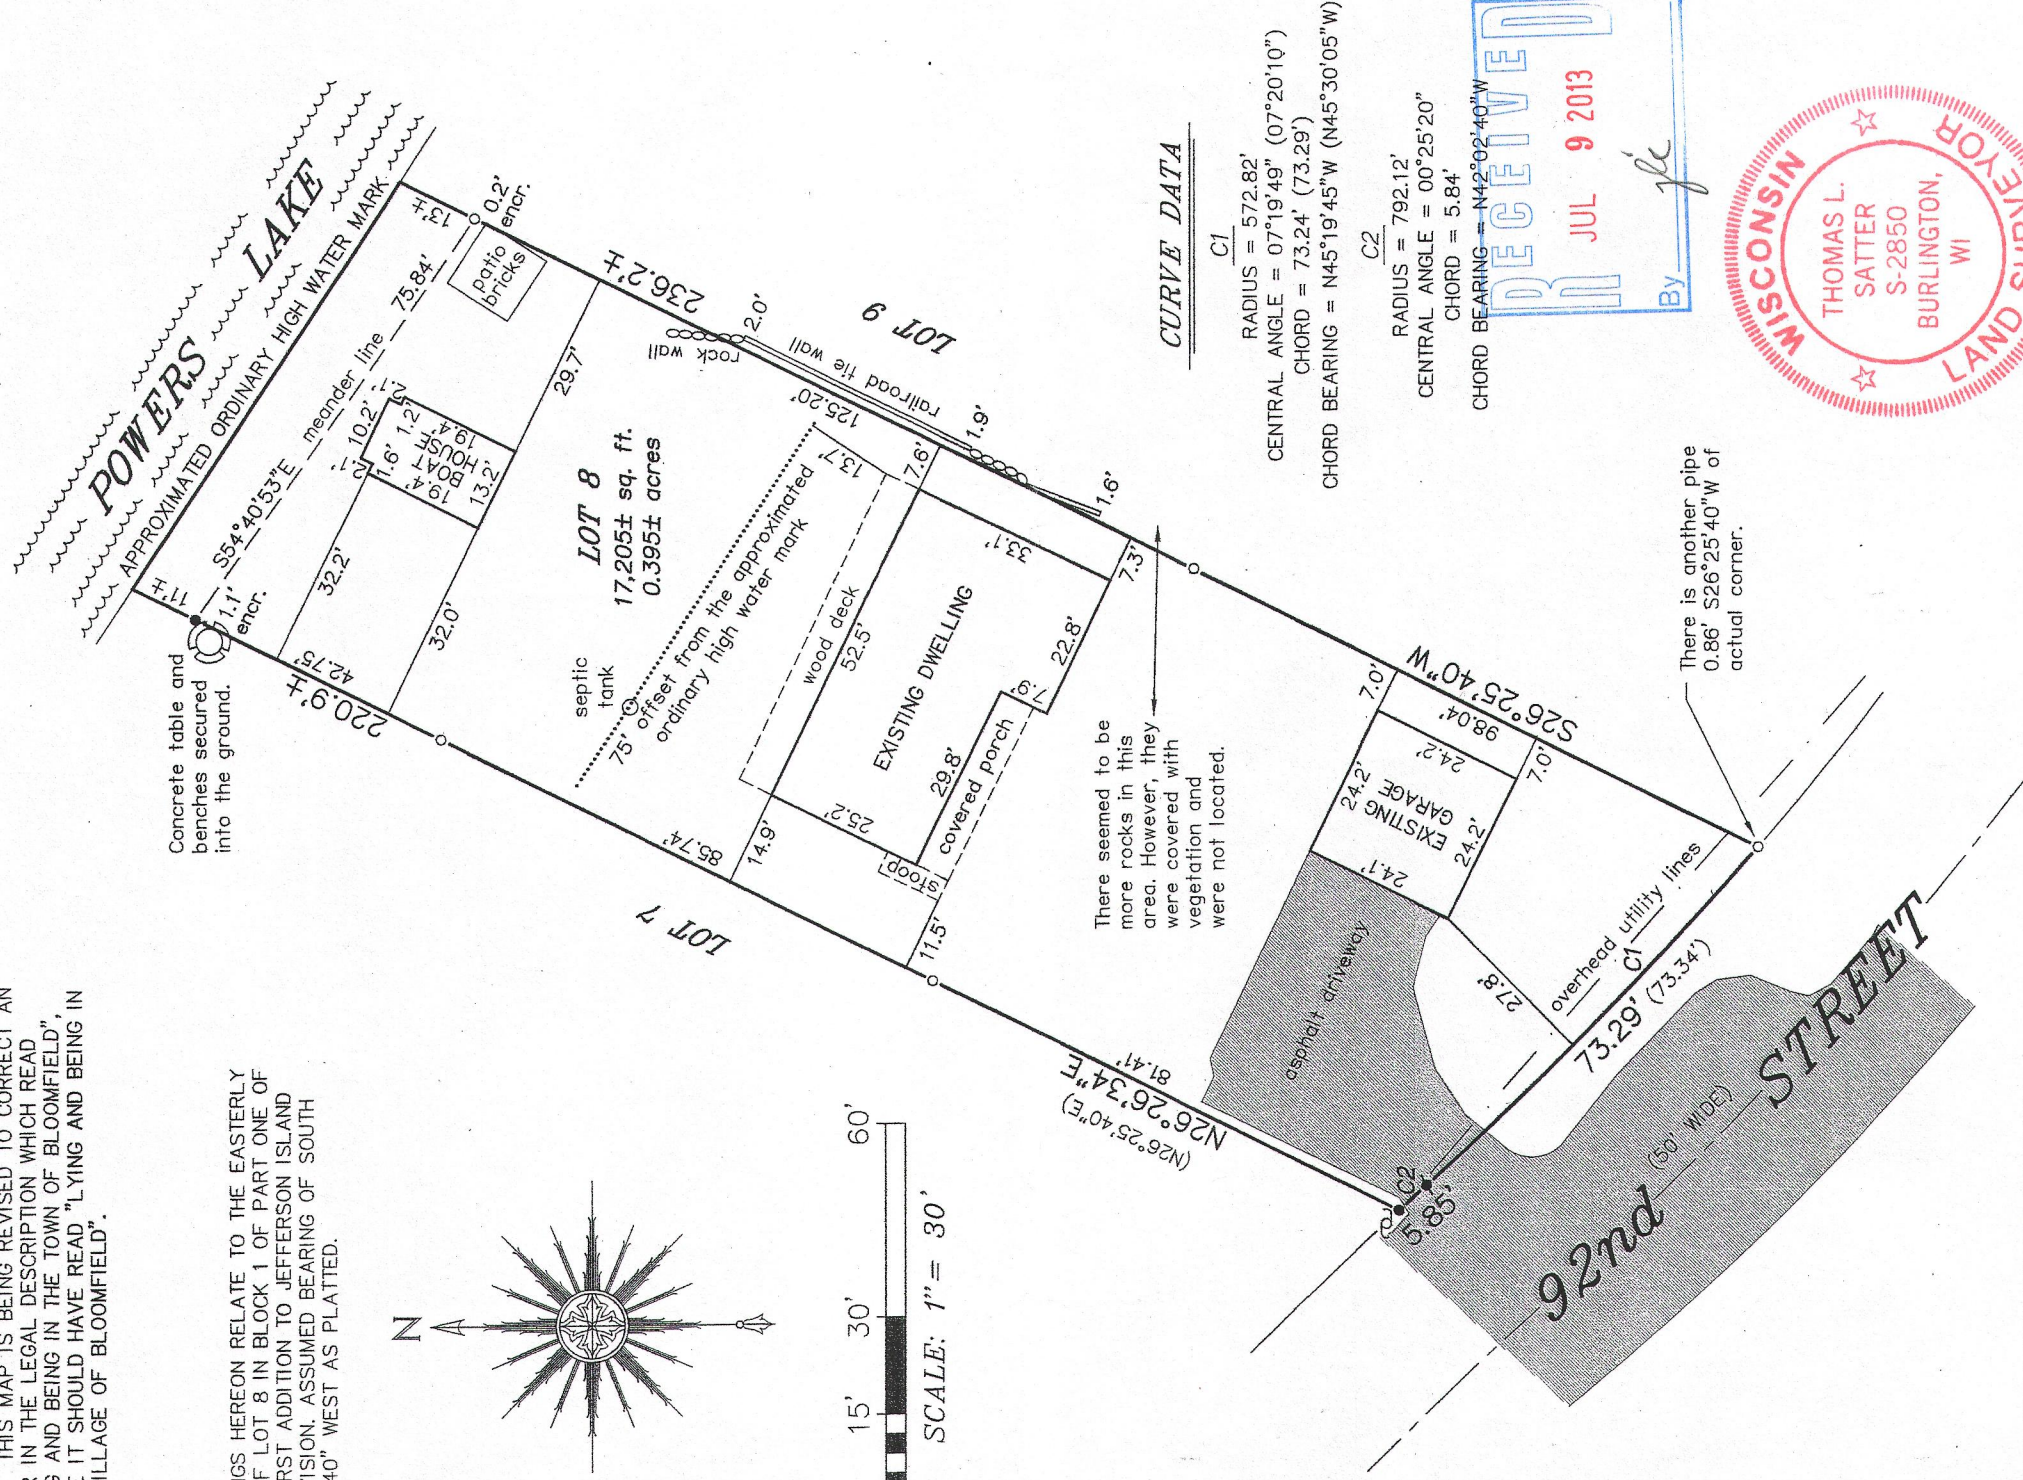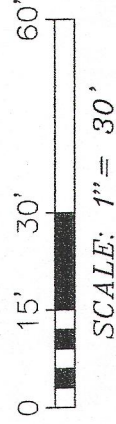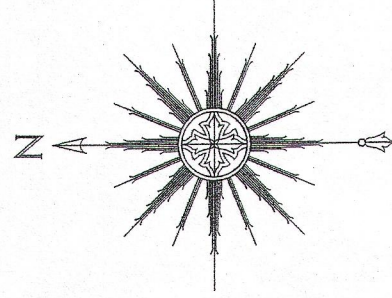


CURVE DATA

C1
RADIUS = 572.82'
CENTRAL ANGLE = 07°19'49" (07°20'10")
CHORD = 73.24' (73.29')
CHORD BEARING = N45°19'45"W (N45°30'05"W)

C2
RADIUS = 792.12'
CENTRAL ANGLE = 00°25'20"
CHORD = 5.84'

CHORD BEARING = N42°02'40"W

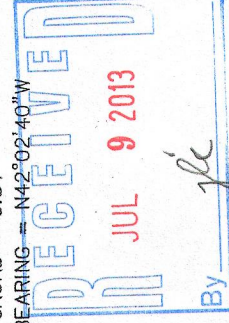

LEGEND

- FOUND IRON PIPE
- SET IRON PIPE
- ✱ SET MASONRY NAIL
- ⌒ UTILITY POLE
- () RECORDED AS

THIS IS NOT AN ORIGINAL PRINT
UNLESS THIS SEAL IS RED.

Thomas L. Satter
THOMAS L. SATTER S-2850

SATTER SURVEYING, LLC
LAND SURVEYS, MAPPING AND PLANNING
272 ORIGIN STREET
BURLINGTON, WI 53105
262-661-4239

REVISED: 6/20/13
JUNE 13, 2013
DATE

061302
JOB NUMBER

8JIS -8

118-3146