

PLAT OF SURVEY

LOTS 2093 THRU 2099 PELL LAKE SUBDIVISION TOWN OF BLOOMFIELD WALWORTH COUNTY, WISCONSIN


Lots 2093, 2094, 2095, 2096, 2097, 2098 and 2099, Block 43, as designated and delineated on the Map entitled "Map of Section 'Two" of Pell Lake, Walworth County, Wisconsin," and recorded in the Office of the Register of Deeds for the County of Walworth and State of Wisconsin on the 16th day of July, 1924.

Parcel No.: &PL 00434

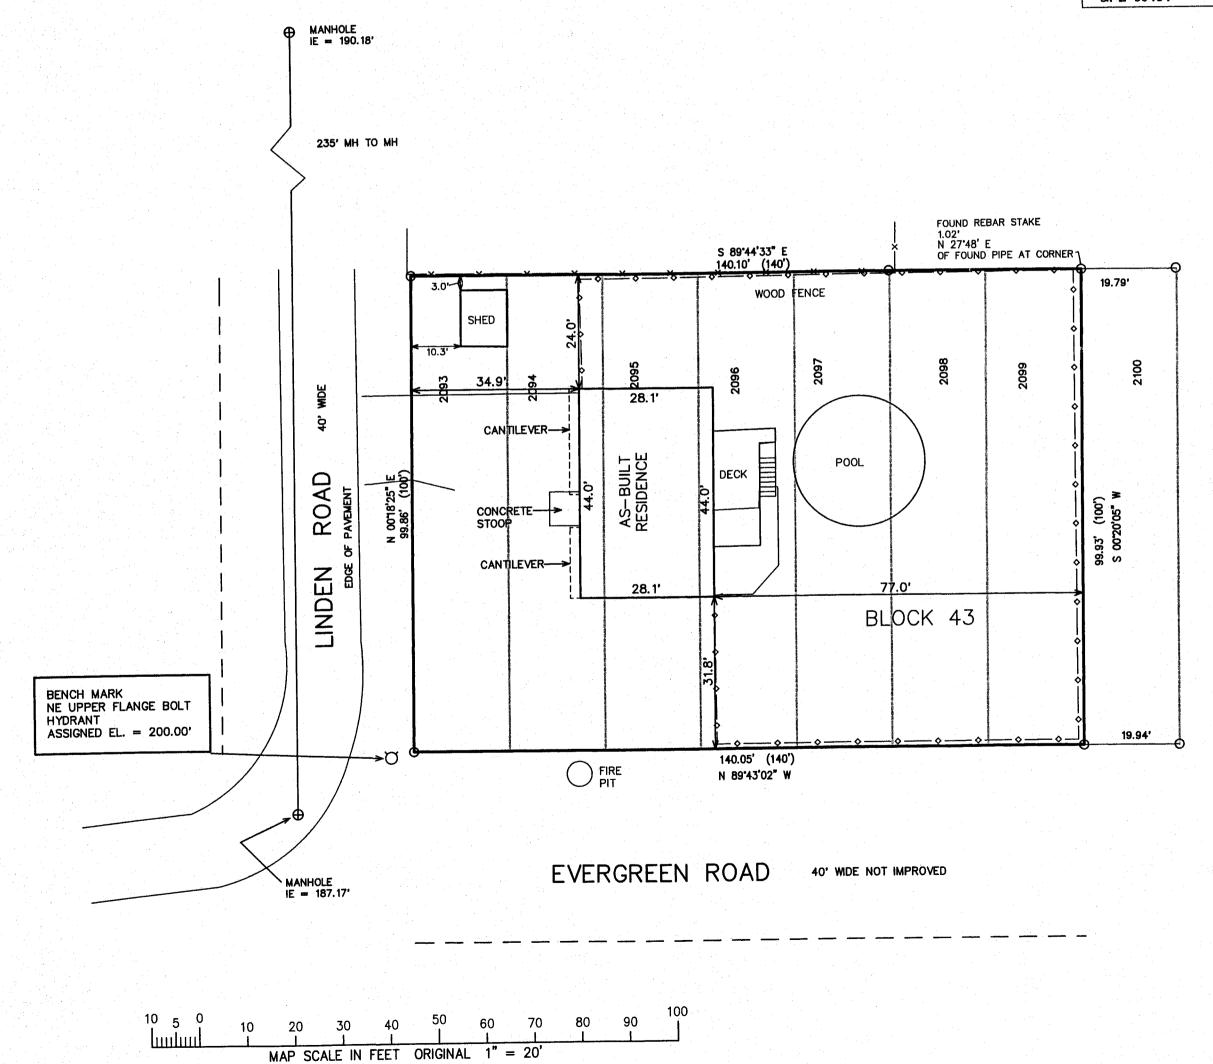

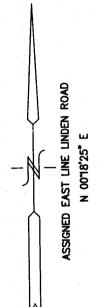

= FOUND IRON PIPE STAKE (xxx) = RECORDED AS

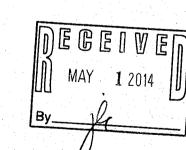

NOTE: COPIES OF THIS MAP TO WHICH THE FOLLOWING CERTIFICATE WILL APPLY SHOW THE SURVEYOR'S ORIGINAL SEAL AND SIGNATURE IN RED INK. COPIES BY ANY OTHER MEANS MAY HAVE ALTERATIONS WHICH DO NOT REPRESENT THE SURVEYOR'S WORK

I HEREBY CERTIFY THAT THE ABOVE DESCRIBED PROPERTY HAS BEEN SURVEYED UNDER MY DIRECTION AND THAT THE ABOVE MAP IS A TRUE REPRESENTATION THEREOF AND SHOWS THE SIZE AND LOCATION OF THE PROPERTY, ITS EXTERIOR BOUNDARIES, THE LOCATION OF ALL VISIBLE STRUCTURES, AND DIMENSIONS OF ALL PRINCIPLE BUILDINGS THEREON, BOUNDARY FENCES, APPARENT EASEMENTS, ROADWAYS, AND VISIBLE ENCROACHMENTS, IF ANY. THIS SURVEY IS MADE FOR THE USE OF THE PRESENT OWNERS OF THE PROPERTY, AND ALSO THOSE WHO PURCHASE, MORTGAGE, OR GUARANTEE THE TITLE THERETO WITHIN ONE YEAR FROM THE DATE HEREOF.

DATED: APRIL 24, 2014

REVISIONS 03/08/2006 TO SHOW SIZE AND LOCATION OF PROPOSED RESIDENCE 06/06/2006 TO SHOW SIZE AND LOCATION OF AS-BUILT RESIDENCE

> PROJECT NO. 5237 DATE: 03-22-99

SHEET NO. 1 OF 1

8PL -434