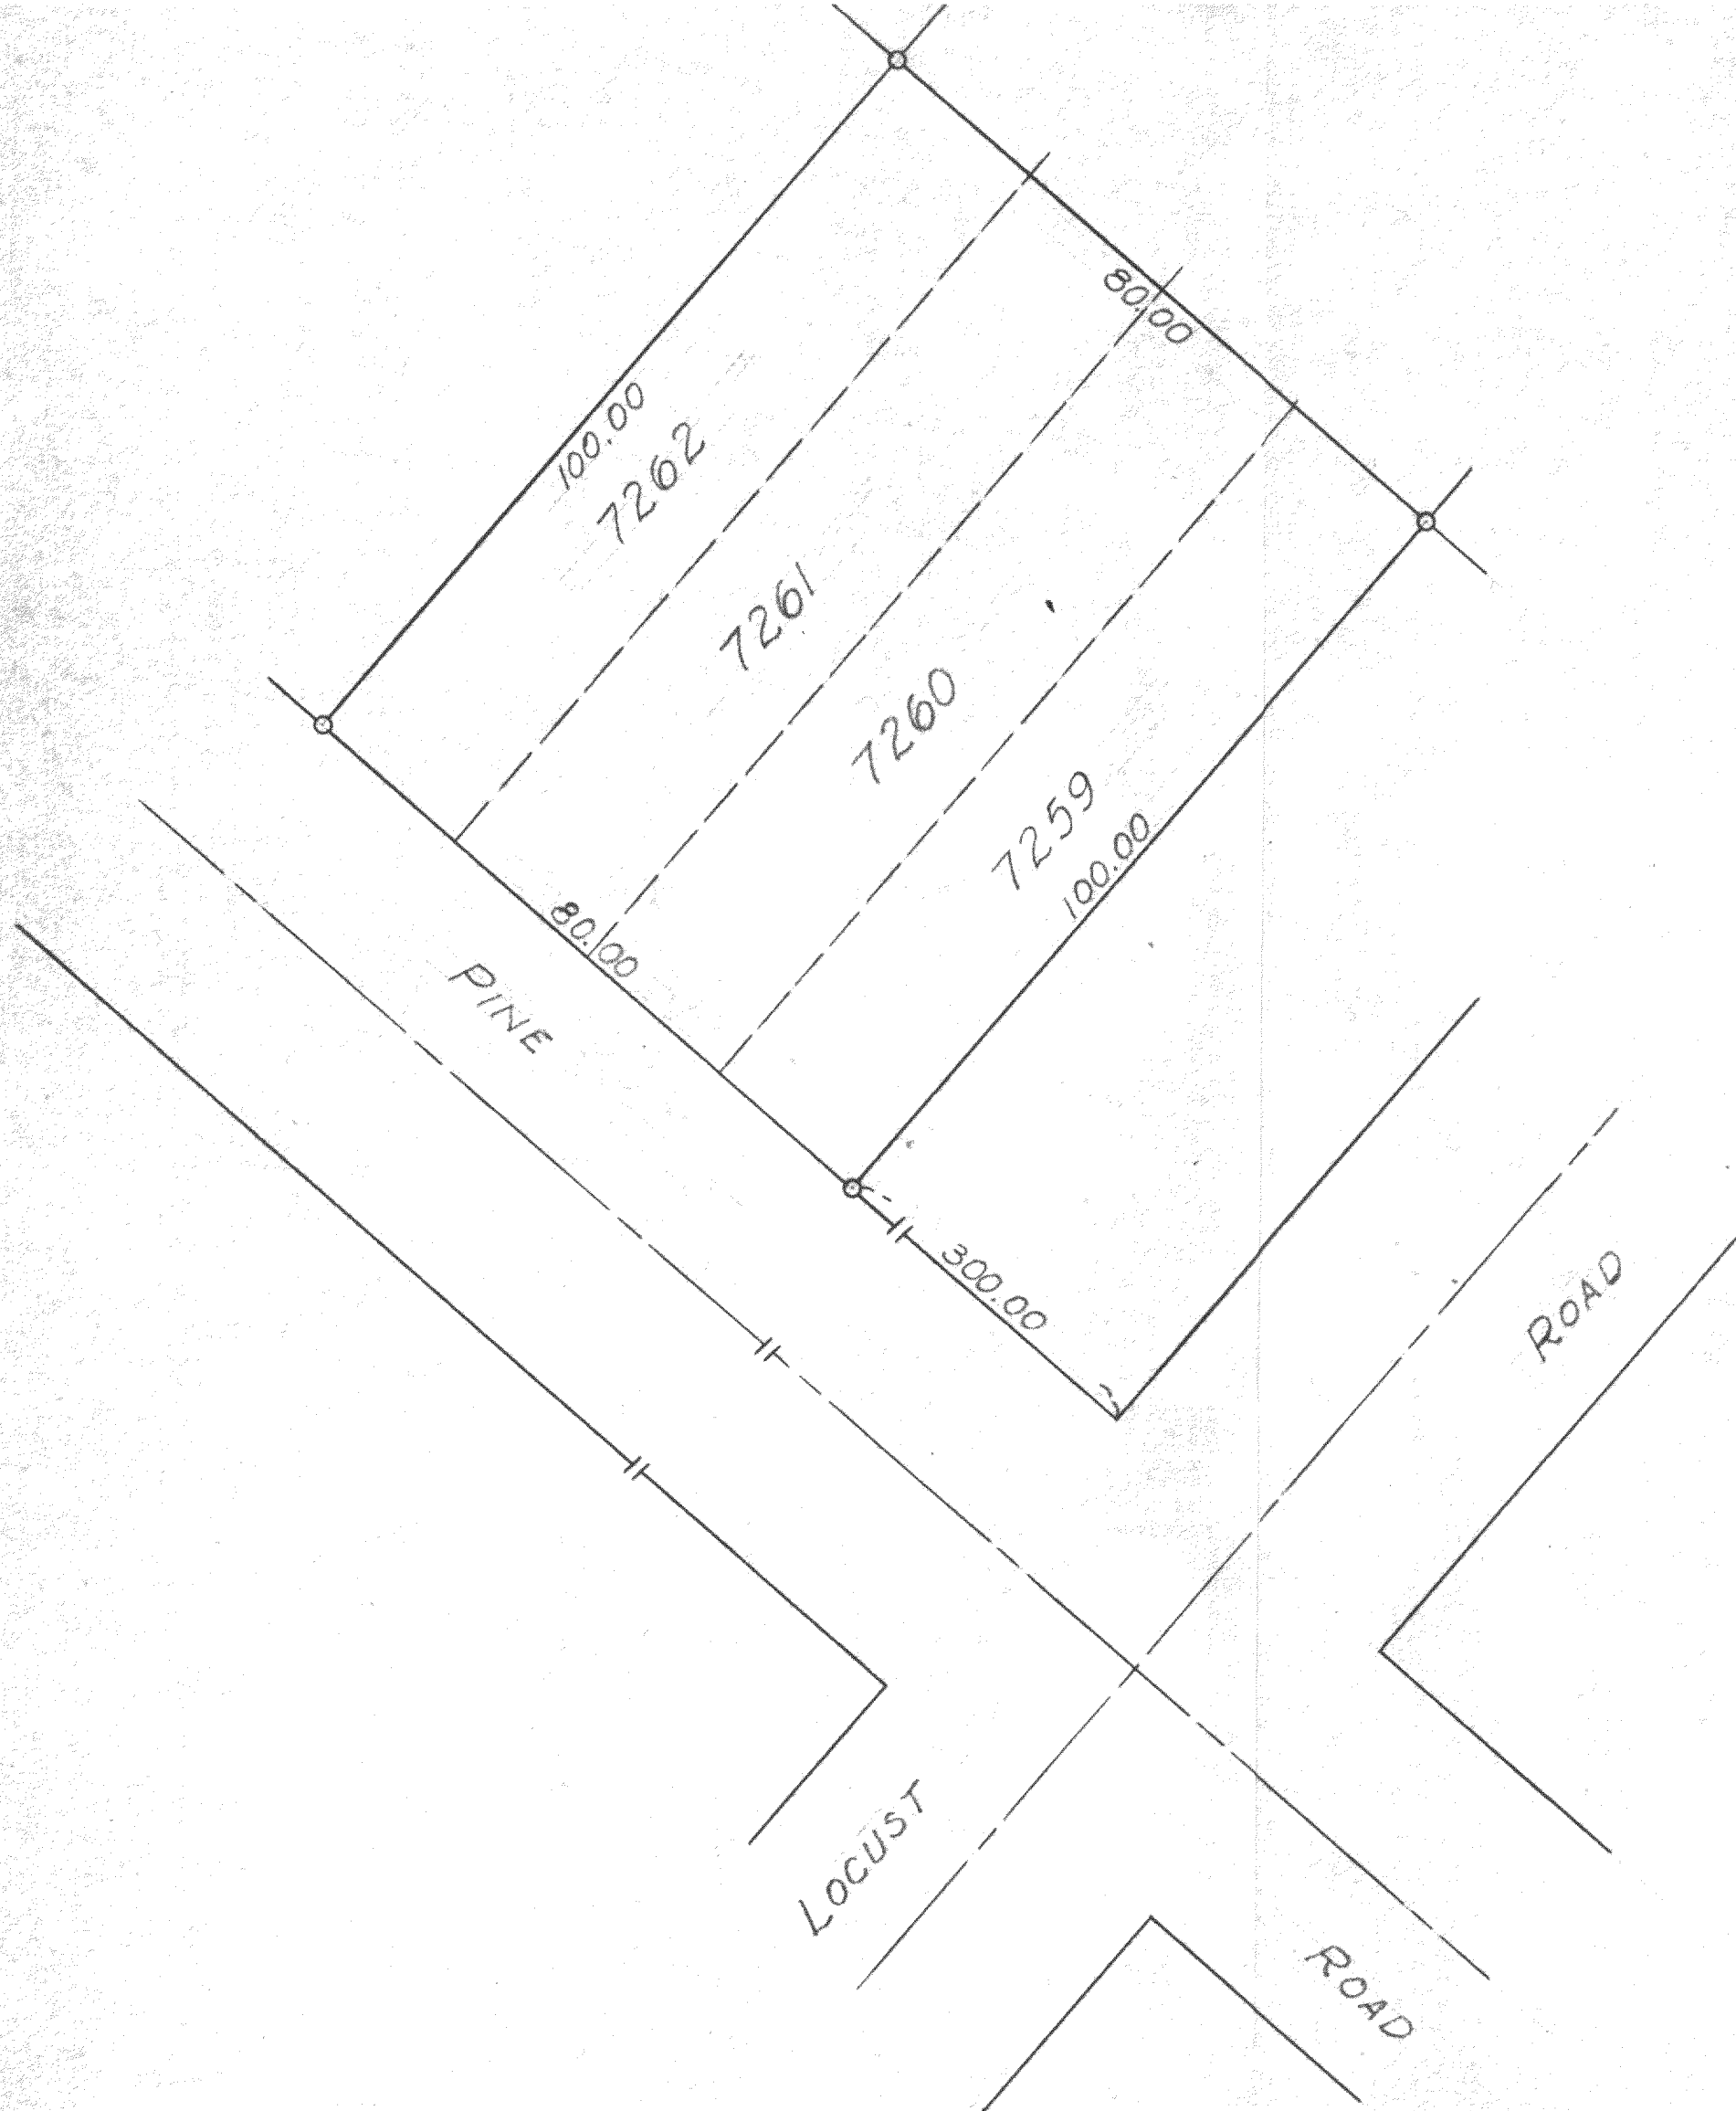


SCALE ~ 1" = 20'
O ~ IRON PIPE

PLAT OF SURVEY OF LOTS 7259 THRU 7262 INCLUSIVE OF SECTION A, PELL
LAKE SUBDIVISION, LOCATED IN T1N R18E OF WALWORTH COUNTY, WISCONSIN.
JULY 17, 1958

George T. Dunham
GEORGE T. DUNHAM, SURVEYOR
DELAVER, WISCONSIN