


HAROLD H. KOLB

REGISTERED PROFESSIONAL LAND SURVEYOR
LAKE GENEVA, WISCONSIN

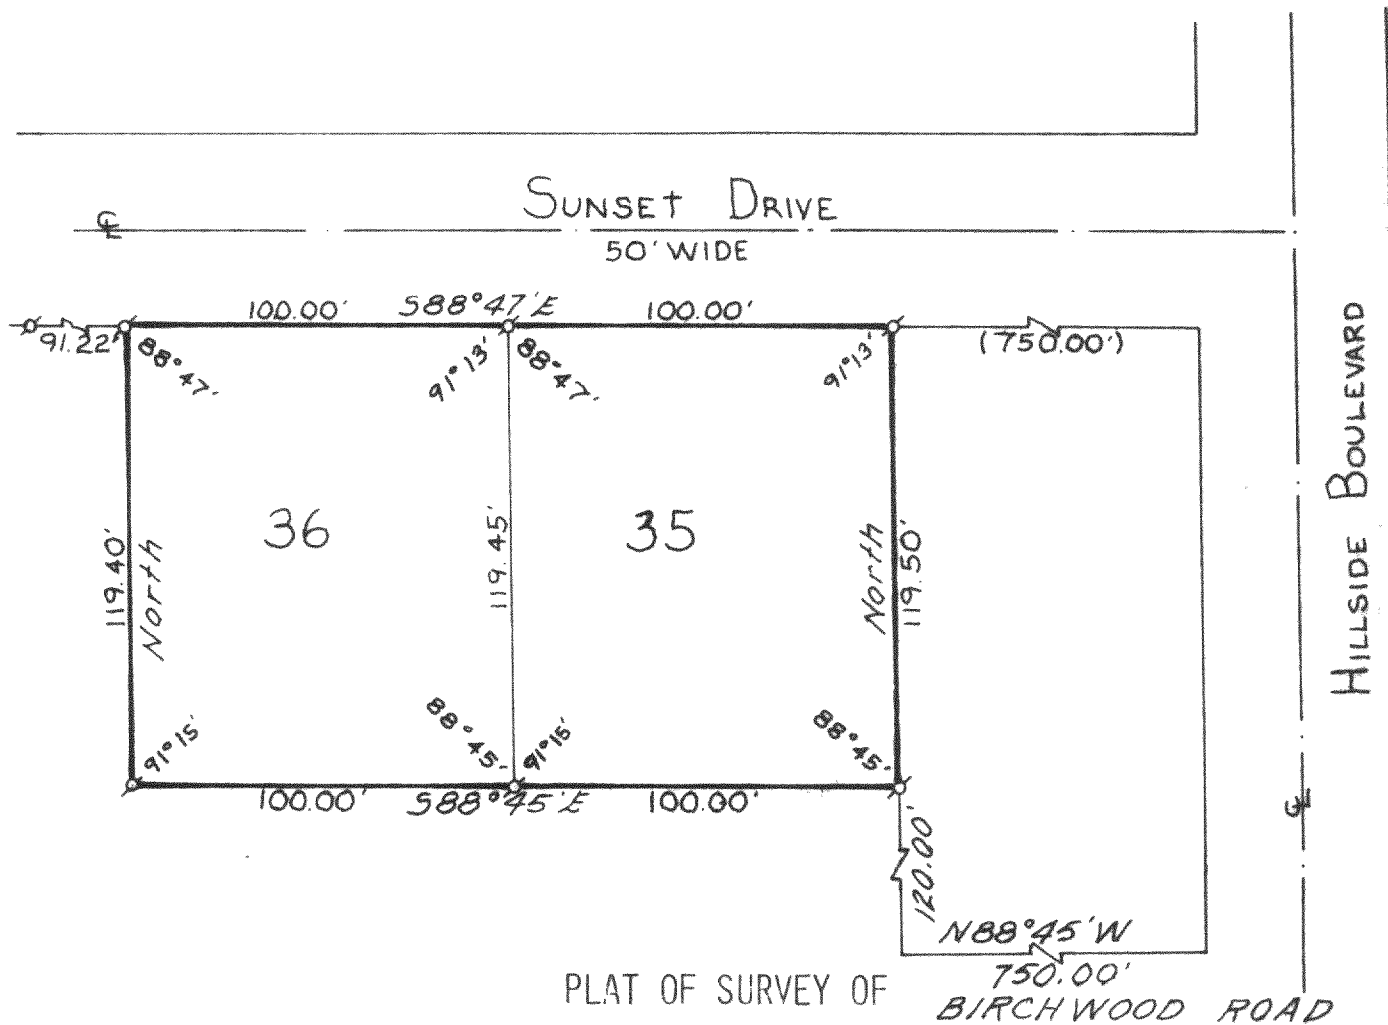

PLAT OF SURVEY OF

750.00'
BIRCHWOOD ROAD

LOTS 35 AND 36 IN THE "GOLF COURSE"
AS SHOWN ON THE RECORDED PLAT OF PELL
LAKE HIGHLANDS IN THE SOUTH 1/4 OF
SECTION 16, TOWN 1 NORTH, RANGE 18
EAST, WALWORTH COUNTY, WISCONSIN.

ORDERED BY: WALLY FITCHEN
HALLMARK REALTY
PELL LAKE, WI 53157



SCALE: 1" = 50'
LEGEND

- — IRON PIPE PLACED, 1" x 24" 1.13 LB./LIN. FT.
- — CONCRETE MONUMENT, 5" DIA. x 30"
- ⌀ — IRON PIPE FOUND () — AS PLATTED

I, HAROLD H. KOLB, DO HEREBY CERTIFY THAT I HAVE
SURVEYED THE PROPERTY HEREON DESCRIBED ACCORDING
TO THE OFFICIAL RECORDS, AND THAT THE PLAT HEREON
IS A CORRECT REPRESENTATION OF THE LOT LINES.

Harold H. Kolb

HAROLD H. KOLB
WISCONSIN REGISTERED LAND SURVEYOR, S-187
DATE June 28, 1978