


LEGEND

- FOUND IRON PIPE
- FOUND "MAG SPIKE"
- ⋈ SET IRON PIPE
- () RECORDED AS
- ▲ UTILITY POLE
- ▣ UTILITY BOX
- OVERHEAD UTILITY LINES

BEARINGS HEREON RELATE TO THE SOUTH LINE OF BLOCK 22 OF LAKE IVANHOE RESORT. ASSUMED BEARING OF SOUTH 89°34'00" WEST TO ORIENTATE WITH PREVIOUS SURVEYS OF RECORD.

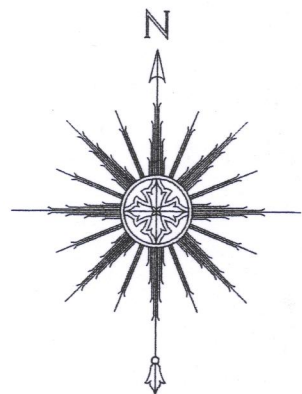


0 15' 30' 60'
SCALE: 1" = 30'

"I HEREBY CERTIFY THAT I HAVE SURVEYED THE ABOVE DESCRIBED PROPERTY AND THAT THE ABOVE MAP IS A CORRECT REPRESENTATION THEREOF AND SHOWS THE SIZE AND LOCATION OF THE PROPERTY, ITS EXTERIOR BOUNDARIES, THE LOCATION OF ALL VISIBLE STRUCTURES AND DIMENSIONS OF ALL PRINCIPAL BUILDINGS THEREON, BOUNDARY FENCES, APPARENT EASEMENTS, ROADWAYS AND ENCROACHMENTS, IF ANY."



"THIS SURVEY IS MADE FOR THE USE OF THE PRESENT OWNERS OF THE PROPERTY, AND THOSE WHO PURCHASE, MORTGAGE, OR GUARANTEE THE TITLE THERETO WITHIN ONE YEAR FROM DATE HEREOF."

SATTER SURVEYING, LLC
LAND SURVEYS, MAPPING AND PLANNING
272 ORIGIN STREET
BURLINGTON, WI 53105
262-661-4239

HOWARD DRIVE (30' WIDE)

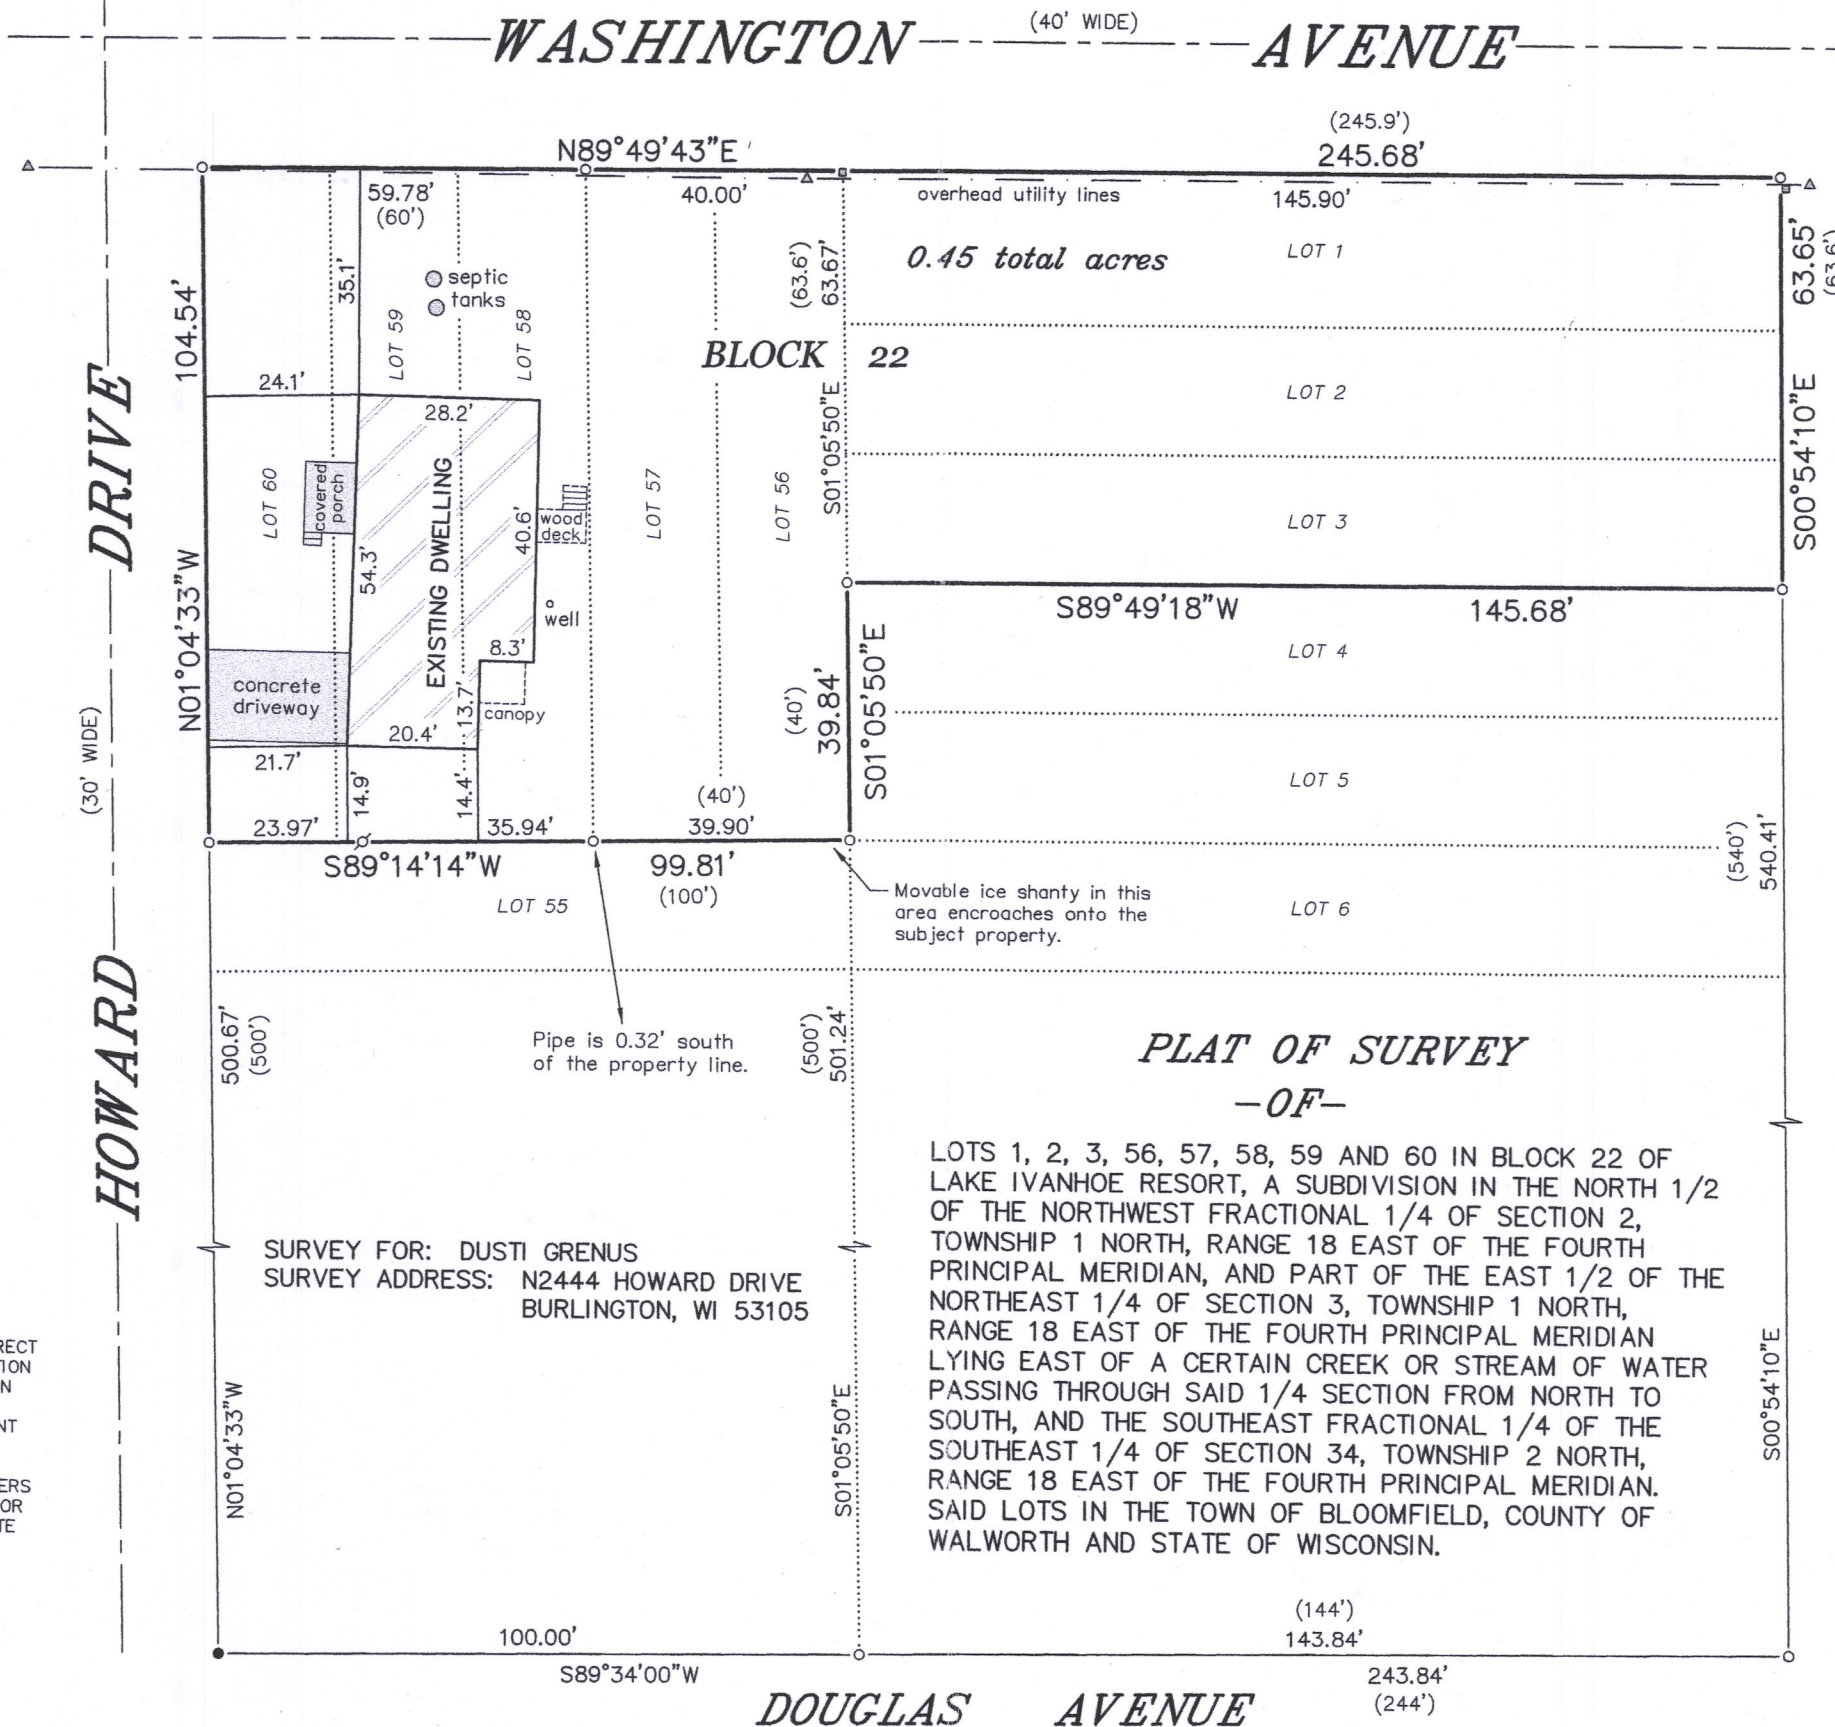

NOTE: REFER TO A CURRENT TITLE REPORT FOR EASEMENTS, RESTRICTIONS OR COVENANTS WHICH MAY AFFECT THIS PROPERTY.

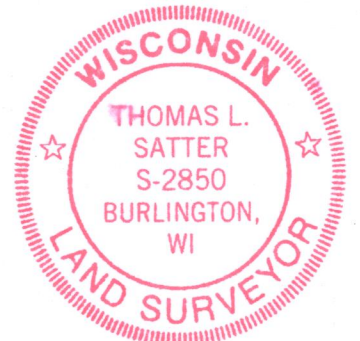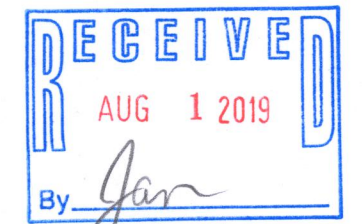

THIS IS NOT AN ORIGINAL PRINT UNLESS THIS SEAL IS RED.

Thomas L. Satter
THOMAS L. SATTER S-2850

JANUARY 9, 2019
DATE

111816
JOB NUMBER

MIR-383 MIR-396

MIR-397

118-3444