


PLAT OF SURVEY

LOCATION: W195 Lake Street, Genoa City, Wisconsin

LEGAL DESCRIPTION: Lot 12 in **WM. ELLIOT'S POWERS LAKE SUBDIVISION**, located in part of the Southeast 1/4 of the Northeast 1/4 of Section 13, Town 1 North, Range 18 East, in the Village of Bloomfield, Walworth County, Wisconsin.

October 2, 2019

Survey No. 110978

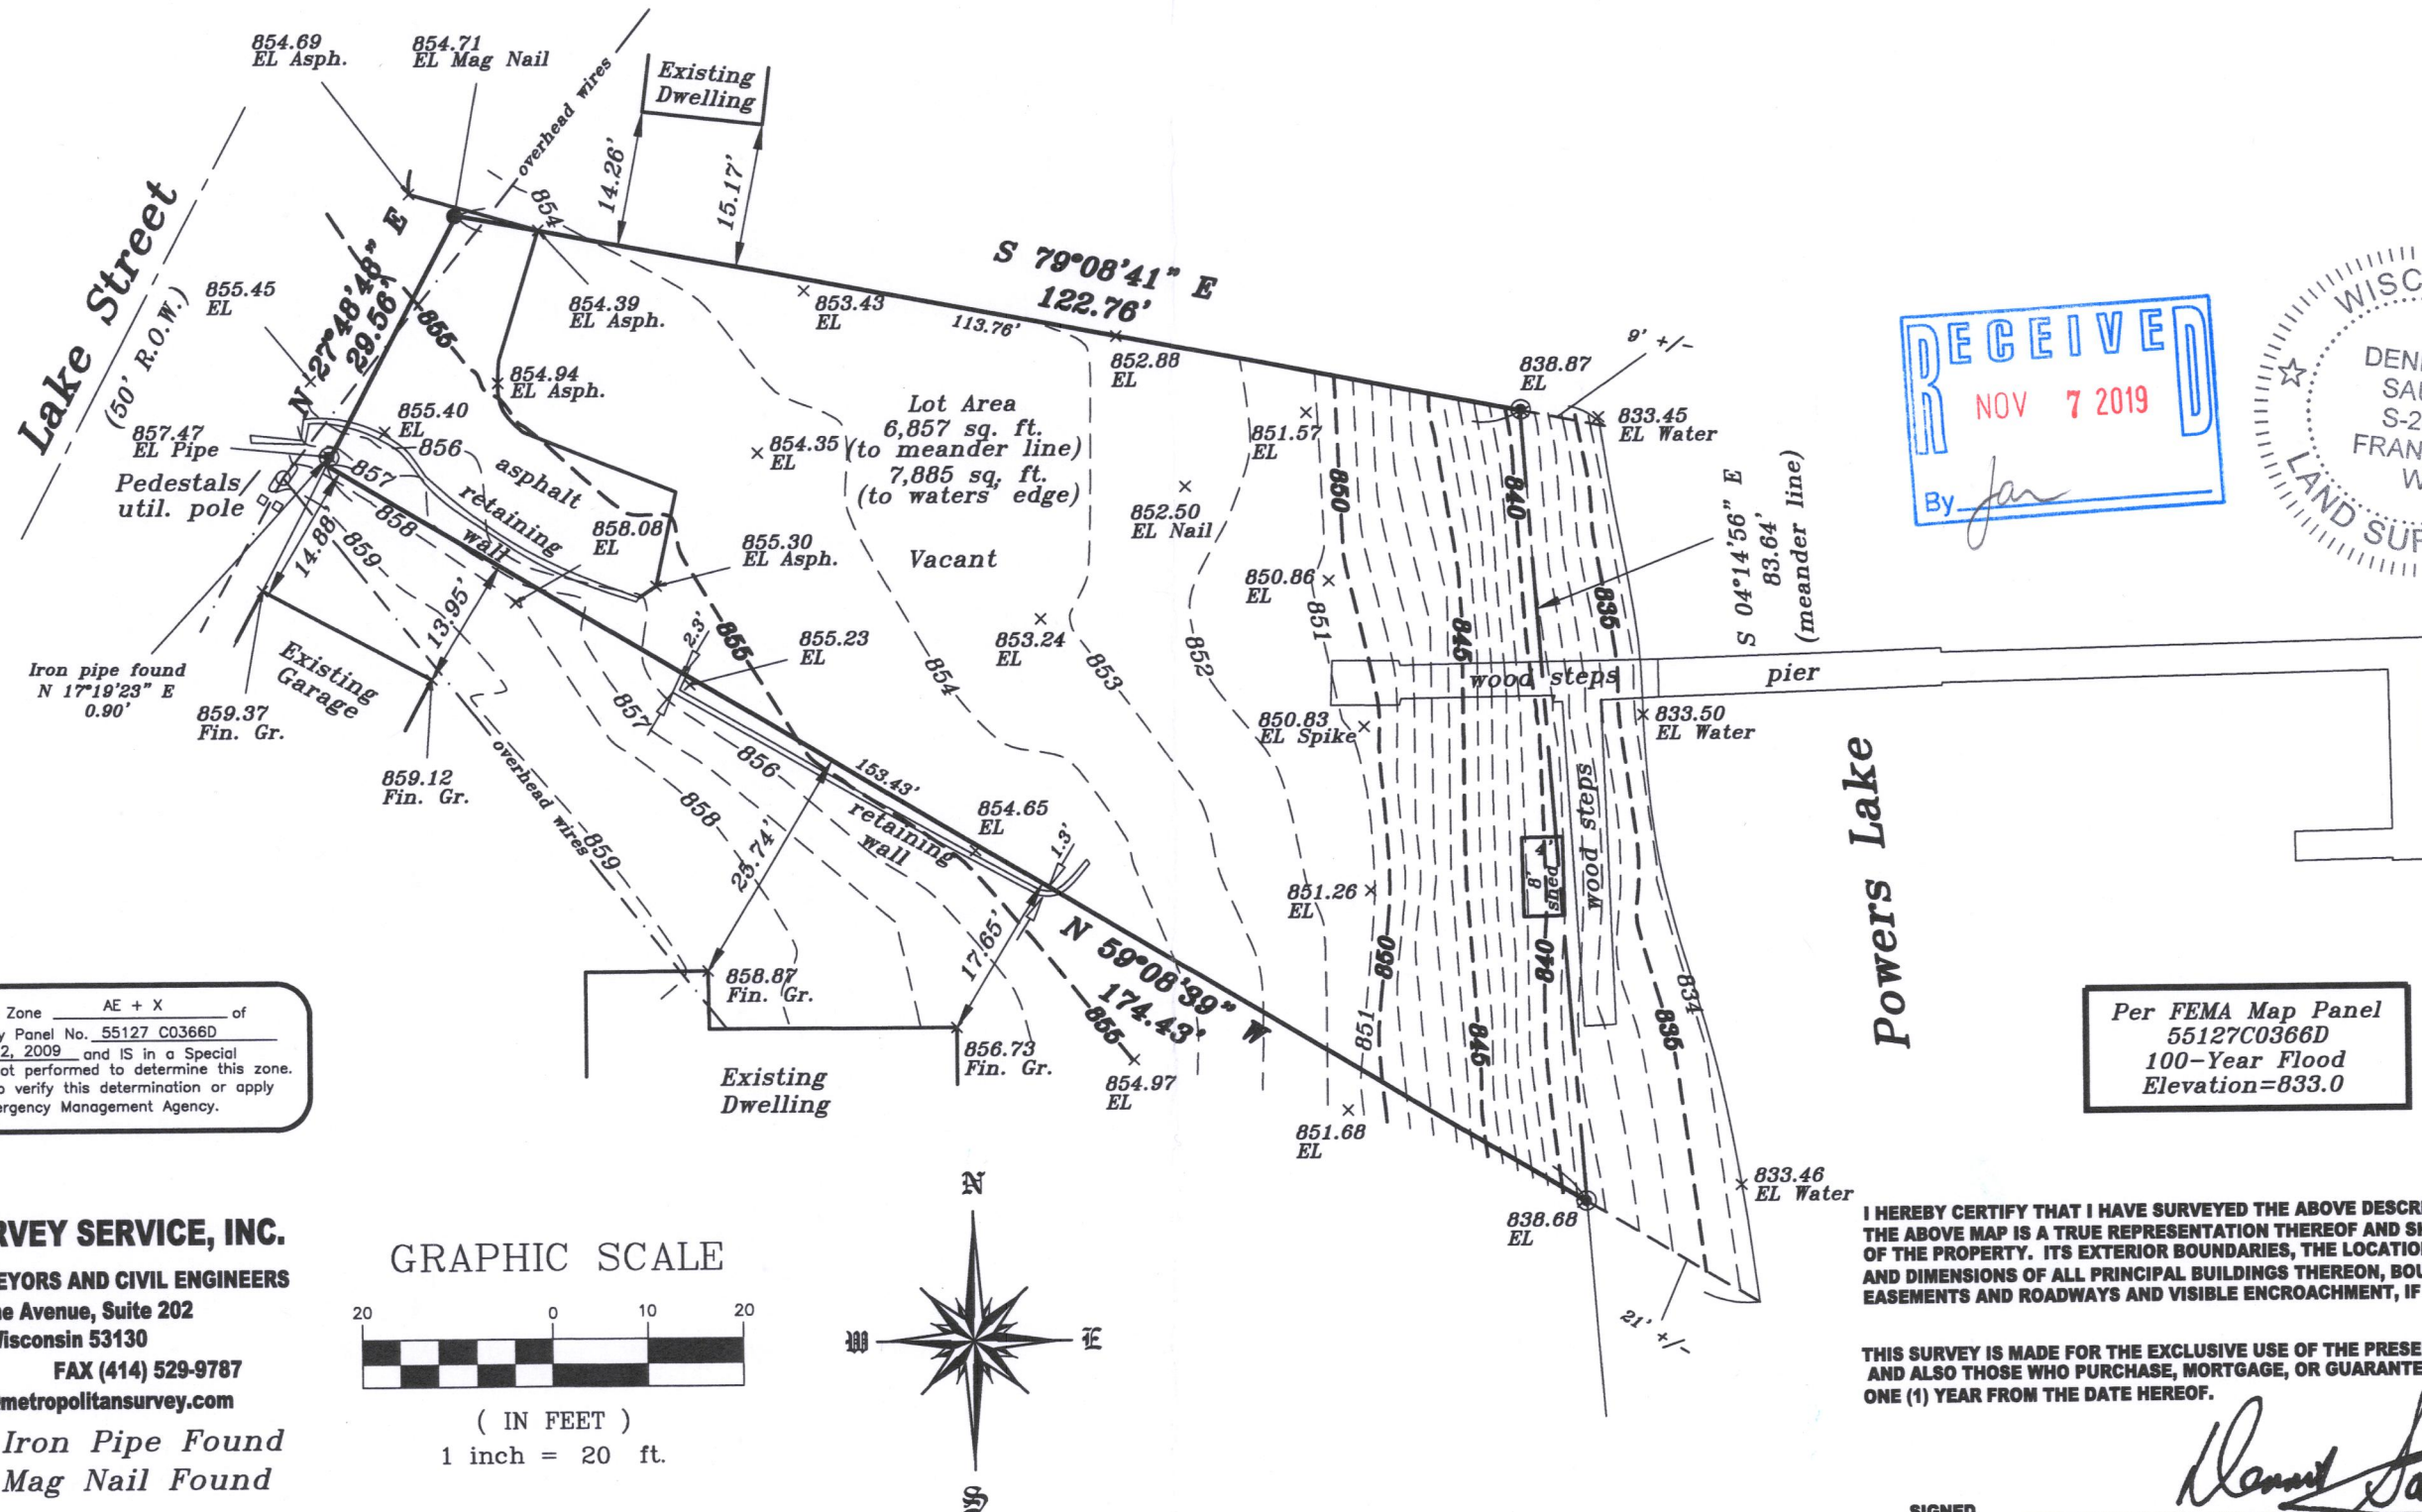

METROPOLITAN SURVEY SERVICE, INC.
PROFESSIONAL LAND SURVEYORS AND CIVIL ENGINEERS
9415 West Forest Home Avenue, Suite 202
Hales Corners, Wisconsin 53130
PH. (414) 529-5380 FAX (414) 529-9787
email address: survey@metropolitansurvey.com
● — Denotes Iron Pipe Found
● — Denotes Mag Nail Found

2E-12

118-3457